

☒ Original Record    ☐ Correction    ☐ Change in Well Use

\_\_\_\_\_

Well ID


[illegible]





Legend

- OE OVERHEAD ELECTRIC & CABLE TV LINE
- W WATER LINE
- GAS GAS LINE
- C UNDERGROUND TELEPHONE LINE
- SS SANITARY SEWER LINE
- MONITORING WELL
- IAS WELL
- SVE WELL

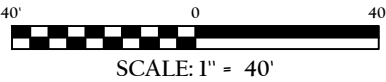

ALL LOCATIONS AND BOUNDARIES ARE APPROXIMATE

	FIGURE: XX.XX	FIGURE NAME: SITE BASE MAP	FORMER FOUR SEASONS 8947 WEST CENTRAL WICHITA, KANSAS KDHE #: C2-087-73100
	DATE: 02-07-20	PROJECT NUMBER: 1874118	
	DRAWN BY: RN	PROJECT MANAGER: SGE	