

☒ Original Record ☐ Correction ☐ Change in Well Use

IAS-28


Well ID

[illegible]



Legend

- OE OVERHEAD ELECTRIC & CABLE TV LINE
- W WATER LINE
- GAS GAS LINE
- C UNDERGROUND TELEPHONE LINE
- SS SANITARY SEWER LINE
- MONITORING WELL
- IAS WELL
- SVE WELL

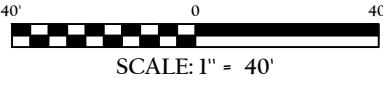

ALL LOCATIONS AND BOUNDARIES ARE APPROXIMATE

	FIGURE: XX.XX	FIGURE NAME: SITE BASE MAP
	DATE: 02-07-20	PROJECT NUMBER: 1874118
	DRAWN BY: RN	PROJECT MANAGER: SGE

FORMER FOUR SEASONS
8947 WEST CENTRAL
WICHITA, KANSAS
KDHE #: C2-087-73100