


WATER WELL RECORD Form WWC-5 KSA 82a-1212

1 LOCATION OF WATER WELL: Sedgwick FRACTION NW 1/4 NE 1/4 SW 1/4 SECTION NUMBER 2 TOWNSHIP NUMBER T 27 S RANGE NUMBER R 1W E/W

Distance and direction from nearest town or city street address of well if located within city? 5217 W. 26th N. Ct, Wichita, Kansas

2 WATER WELL OWNER: SHARP HOMES Board of Agriculture, Division of Water Resource RR#.ST. ADDRESS.BOX #: 2131 N. Collective Ste #A Application Number: CITY, STATE: Wichita, Kansas ZIP CODE: Application Number:

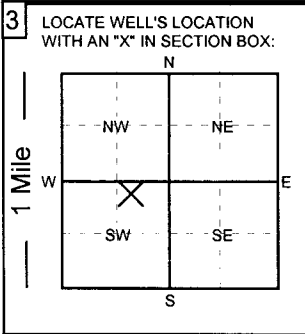

3 LOCATE WELL'S LOCATION WITH AN "X" IN SECTION BOX: 4 DEPTH OF COMPLETED WELL: 35 ft. ELEVATION: WELL'S STATIC WATER LEVEL 12 FT. BELOW LAND SURFACE MEASURED ON mo/day/yr: 3/13/20

5 TYPE OF CASING USED: 1. Steel 2. PVC 3. RPM (SR) 4. ABS 5. Wrought Iron 6. Asbestos-Cement 7. Fiberglass 8. Concrete tile 9. Other (Specify below) CASING JOINTS: Glued Threaded Welded Clamped

6 GROUT MATERIALS: 1. Neat cement 2. Cement Grout 3. Bentonite Other bentonite hole plug Grout Intervals: From 4 ft. to 24 ft.

Table with 2 columns: From, To, LITHOLOGIC LOG. Entries include 0-3 sandy soil, 3-23 fine sand, 23-35 medium sand.

7 Contractor's or Landowner's Certification: This water well was 1. constructed 2. reconstructed or 3. plugged under my jurisdiction and was completed on (mo/day/year) 3/13/2020