


# WATER WELL RECORD Form WWC-5 KSA 82a-1212

1 LOCATION OF WATER WELL: <b>Sedgwick</b>	FRACTION <b>SE 1/4 SE 1/4 NW 1/4</b>	SECTION NUMBER <b>2</b>	TOWNSHIP NUMBER <b>T 27 S</b>	RANGE NUMBER <b>R 1W EW</b>
----------------------------------------------	-----------------------------------------	----------------------------	----------------------------------	--------------------------------

Distance and direction from nearest town or city street address of well if located within city?

**2722 N. Anna Wichita, Kansas**

2 WATER WELL OWNER: <b>SHARP HOMES</b>	RR# ST. ADDRESS, BOX #: <b>2131 N. Collective Ste # A</b>	Board of Agriculture, Division of Water Resource
CITY, STATE: <b>Wichita, Kansas</b>		Application Number:
ZIP CODE:		

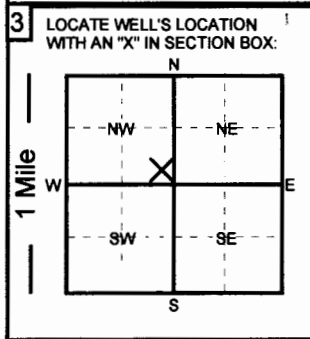

4 DEPTH OF COMPLETED WELL: <b>36</b> ft.	ELEVATION:
Depth of groundwater Encountered: _____ ft.	
WELL'S STATIC WATER LEVEL <b>12</b> FT. BELOW LAND SURFACE MEASURED ON <b>11/7/20</b>	
Pump test data: Well water was _____ ft. after _____ hours of pumping @ _____ gpm	
Est. Yield: _____ gpm Well water was _____ ft. after _____ hours of pumping @ _____ gpm	
Bore Hole Diameter <b>12</b> in. to <b>36</b> ft. and _____ in. to _____ ft.	
WELL WATER TO BE USED AS:	
1. Domestic <input type="checkbox"/> 3. Feedlot <input type="checkbox"/> 5. Public water supply <input type="checkbox"/> <u>7. Lawn and garden only</u> <input checked="" type="checkbox"/> 9. Dewatering <input type="checkbox"/> 11. Injection well <input type="checkbox"/>	
2. Irrigation <input type="checkbox"/> 4. Industrial <input type="checkbox"/> 6. Oil field water supply <input type="checkbox"/> 8. Air conditioning <input type="checkbox"/> 10. Monitoring well <input type="checkbox"/> 12. Other (Specify below) _____	
Was a chemical/bacteriological sample submitted to Department? YES <input type="checkbox"/> NO <input checked="" type="checkbox"/> ; If yes, what mo/day/yr was sample submitted _____	
Was Water Well Disinfected? YES <input type="checkbox"/> NO <input checked="" type="checkbox"/>	

5 TYPE OF CASING USED:	5. Wrought Iron	7. Fiberglass	9. Other (Specify below)	CASING JOINTS: <u>Glued</u> <input checked="" type="checkbox"/> Threaded	Welded <input type="checkbox"/> Clamped <input type="checkbox"/>
1. Steel <input type="checkbox"/> 3. RPM (SR) <input type="checkbox"/>	6. Asbestos-Cement <input type="checkbox"/>	8. Concrete tile <input type="checkbox"/>	SDR-26		
<u>2. PVC</u> <input checked="" type="checkbox"/> 4. ABS <input type="checkbox"/>					
Blank casing diameter <b>5</b> in. to <b>26</b> ft., Dia. _____ in. to _____ ft., Dia. _____ in. to _____ ft.					
Casing height above land surface: <b>12</b> in., Weight: <b>2.35</b> lbs. / ft. Wall thickness or gauge No. <b>.214</b>					
TYPE OF SCREEN OR PERFORATION MATERIAL:					
1. Steel <input type="checkbox"/> 3. Stainless Steel <input type="checkbox"/> 5. Fiberglass <input type="checkbox"/> <u>7. PVC</u> <input checked="" type="checkbox"/> 9. ABS <input type="checkbox"/> 11. Other (specify) _____					
2. Brass <input type="checkbox"/> 4. Galvanized <input type="checkbox"/> 6. Concrete Tile <input type="checkbox"/> 8. RMP (SR) <input type="checkbox"/> 10. Asbestos-Cement <input type="checkbox"/> 12. None used (open hole) _____					
SCREEN OR PERFORATION OPENINGS ARE:					
1. Continuous slot <input type="checkbox"/> 3. Mill slot <input type="checkbox"/> 5. Gauzed wrapped <input type="checkbox"/> 7. Torch cut <input type="checkbox"/> 9. Drilled holes <input type="checkbox"/> 11. None (open hole) <input type="checkbox"/>					
2. Louvered shutter <input type="checkbox"/> 4. Key punched <input type="checkbox"/> 6. Wire wrapped <input type="checkbox"/> <u>8. Saw cut</u> <input checked="" type="checkbox"/> 10. Other (specify) _____					
SCREEN - PERFORATION INTERVAL	From	<b>26</b> ft.	to	<b>36</b> ft.,	From _____ ft. to _____ ft.
GRAVEL PACK INTERVALS:	From	<b>24</b> ft.	to	<b>36</b> ft.,	From _____ ft. to _____ ft.

6 GROUT MATERIALS:	1. Neat cement	2. Cement Grout	3. Bentonite	Other <b>bentonite hole plug</b>
Grout Intervals: From _____ ft. to _____ ft., From _____ ft. to _____ ft., From _____ ft. to _____ ft., From <b>4</b> ft. to <b>24</b> ft.				
What is the nearest source of possible contamination:				
1. Septic tank <input type="checkbox"/> 4. Lateral lines <input type="checkbox"/> 7. Pit privy <input type="checkbox"/> 10. Livestock pens <input type="checkbox"/> 13. Insecticide storage <input type="checkbox"/> 15. Oil well/Gas well <input type="checkbox"/>				
2. Sewer lines <input type="checkbox"/> 5. Cess Pool <input type="checkbox"/> 8. Sewage lagoon <input type="checkbox"/> 11. Fuel storage <input type="checkbox"/> 14. Abandon water well <input type="checkbox"/> 16. Other (specify below) _____				
<u>3. Watertight sewer line</u> <input checked="" type="checkbox"/> 6. Seepage pit <input type="checkbox"/> 9. Feed yard <input type="checkbox"/> 12. Fertilizer storage <input type="checkbox"/>				
Direction from well? <b>West</b>				How many feet? <b>50 ft. plus</b>

From	To	LITHOLOGIC LOG	From	To	LITHOLOGIC LOG
0	3	topsoil			
3	27	fine sand			
27	36	medium sand			

7 Contractor's or Landowner's Certification: This water well was 1. constructed  2. reconstructed  or 3. plugged  under my jurisdiction and was completed on (mo/day/year) **11/7/20** and this record is true to the best of my knowledge and belief.

Kansas Water Well Contractor's License No. **236** This water well record was completed on (mo/day/year) **11/10/2020**

under the business name of **Harp Well and Pump Service** by (signature) *Todd S. Harp*