


WATER WELL RECORD Form WWC-5

Division of Water Resources App. No. [ ] Well ID [ ]

[X] Original Record [ ] Correction [ ] Change in Well Use

1 LOCATION OF WATER WELL: County: Sedgwick Fraction SW 1/4 NE 1/4 SW 1/4 SE 1/4 Section Number 4 Township Number T 27 S Range Number R 1 [ ] E [X] W

2 WELL OWNER: Last Name: OSTRANDER First: Matthew Street or Rural Address where well is located (if unknown, distance and direction from nearest town or intersection): If at owner's address, check here: [X] Business: Address: 2335 N. Tee Time Ct. City: Wichita State: Kansas ZIP: 67205

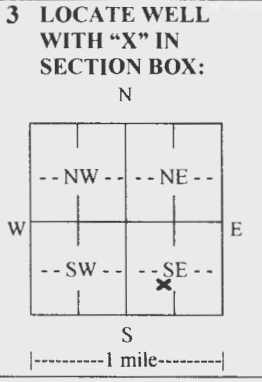

3 LOCATE WELL WITH 'X' IN SECTION BOX: N W E S | 4 DEPTH OF COMPLETED WELL: 80 ft. Depth(s) Groundwater Encountered: 1) ... ft. 2) ... ft. 3) ... ft., or 4) [ ] Dry Well WELL'S STATIC WATER LEVEL: 28 ft. [X] below land surface, measured on (mo-day-yr) 07/25/22 [ ] above land surface, measured on (mo-day-yr) ... Pump test data: Well water was ... ft. after ... hours pumping ... gpm Well water was ... ft. after ... hours pumping ... gpm Estimated Yield: ... gpm Bore Hole Diameter: 12 in. to 80 ft. and ... in. to ... ft.

5 Latitude: 37.72535 (decimal degrees) Longitude: -97.43213 (decimal degrees) Horizontal Datum: [X] WGS 84 [ ] NAD 83 [ ] NAD 27 Source for Latitude/Longitude: [X] GPS (unit make/model: iPhone (WAAS enabled? [ ] Yes [ ] No) [ ] Land Survey [ ] Topographic Map [ ] Online Mapper: ...

6 Elevation: ... ft. [ ] Ground Level [ ] TOC Source: [ ] Land Survey [X] GPS [ ] Topographic Map [ ] Other ...

7 WELL WATER TO BE USED AS: 1. Domestic: [ ] Household [X] Lawn & Garden [ ] Livestock 2. [ ] Irrigation 3. [ ] Feedlot 4. [ ] Industrial 5. [ ] Public Water Supply: well ID ... 6. [ ] Dewatering: how many wells? ... 7. [ ] Aquifer Recharge: well ID ... 8. [ ] Monitoring: well ID ... 9. Environmental Remediation: well ID ... [ ] Air Sparge [ ] Soil Vapor Extraction [ ] Recovery [ ] Injection 10. [ ] Oil Field Water Supply: lease ... 11. Test Hole: well ID ... [ ] Cased [ ] Uncased [ ] Geotechnical 12. Geothermal: how many bores? ... a) Closed Loop [ ] Horizontal [ ] Vertical b) Open Loop [ ] Surface Discharge [ ] Inj. of Water 13. [ ] Other (specify): ...

Was a chemical/bacteriological sample submitted to KDHE? [ ] Yes [X] No If yes, date sample was submitted: ... Water well disinfected? [X] Yes [ ] No

8 TYPE OF CASING USED: [ ] Steel [X] PVC [ ] Other ... CASING JOINTS: [ ] Glued [ ] Clamped [ ] Welded [ ] Threaded Casing diameter ... 5 in. to ... 80 ft., Diameter ... in. to ... ft., Diameter ... in. to ... ft. Casing height above land surface ... 12 in. Weight ... 2.35 lbs./ft. Wall thickness or gauge No. SDR-26

TYPE OF SCREEN OR PERFORATION MATERIAL: [ ] Steel [ ] Stainless Steel [ ] Fiberglass [X] PVC [ ] Other (Specify) ... [ ] Brass [ ] Galvanized Steel [ ] Concrete tile [ ] None used (open hole)

SCREEN OR PERFORATION OPENINGS ARE: [ ] Continuous Slot [ ] Mill Slot [ ] Gauze Wrapped [ ] Torch Cut [ ] Drilled Holes [ ] Other (Specify) ... [ ] Louvered Shutter [ ] Key Punched [ ] Wire Wrapped [X] Saw Cut [ ] None (Open Hole)

SCREEN-PERFORATED INTERVALS: From 60 ft. to 80 ft., From ... ft. to ... ft. GRAVEL PACK INTERVALS: From 24 ft. to 80 ft., From ... ft. to ... ft., From ... ft. to ... ft.

9 GROUT MATERIAL: [ ] Neat cement [ ] Cement grout [X] Bentonite [ ] Other ... Grout Intervals: From 4 ft. to 24 ft., From ... ft. to ... ft., From ... ft. to ... ft.

Nearest source of possible contamination: [ ] Septic Tank [ ] Lateral Lines [ ] Pit Privy [ ] Livestock Pens [ ] Insecticide Storage [ ] Sewer Lines [ ] Cess Pool [ ] Sewage Lagoon [ ] Fuel Storage [ ] Abandoned Water Well [X] Watertight Sewer Lines [ ] Seepage Pit [ ] Feedyard [ ] Fertilizer Storage [ ] Oil Well/Gas Well [ ] Other (Specify) ... Direction from well? North Distance from well? 50 ft. plus ... ft.

Table with 6 columns: 10 FROM, TO, LITHOLOGIC LOG, FROM, TO, LITHO. LOG (cont.) or PLUGGING INTERVALS. Rows show soil layers: 0-3 topsoil, 3-28 clay, 28-35 fine sand, 35-50 black clay, 50-60 fine sand, 60-80 medium sand.

Notes:

11 CONTRACTOR'S OR LANDOWNER'S CERTIFICATION: This water well was [X] constructed, [ ] reconstructed, or [ ] plugged under my jurisdiction and was completed on (mo-day-year) 07/25/2022.. and this record is true to the best of my knowledge and belief. Kansas Water Well Contractor's License No. 236 This Water Well Record was completed on (mo-day-year) 7/27/2022 under the business name of Harp Well and Pump Service Signature Todd S. Harp