

1 LOCATION OF WATER WELL:	Fraction	Section Number	Township Number	Range Number
County: SEDGWICK SW	NE 1/4 NW 1/4 SE 1/4	11	T 27 S	R 1 NE

Distance and direction from nearest town or city street address of well if located within city?

1726 N. Young

2 WATER WELL OWNER: Doug/Denise Kelley

RR#, St. Address, Box #: 1726 N. Young


Board of Agriculture, Division of Water Resources

City, State, ZIP Code: Wichita KS 67212

Application Number:

3 LOCATE WELL'S LOCATION WITH AN "X" IN SECTION BOX: 4 DEPTH OF COMPLETED WELL: 33'6" ft. ELEVATION:

AN "X" IN SECTION BOX:

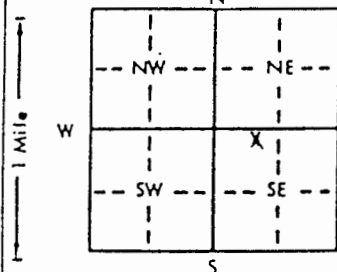

Depth(s) Groundwater Encountered 14'6" ft. 2. ft. 3. ft.

WELL'S STATIC WATER LEVEL 14'6" ft. below land surface measured on mo/day/yr 11/1/93

Pump test data: Well water was ft. after hours pumping gpm

Est. Yield gpm: Well water was ft. after hours pumping gpm

Bore Hole Diameter in. to ft. and in. to ft.

WELL WATER TO BE USED AS: 5 Public water supply 8 Air conditioning 11 Injection well

X 1 Domestic 3 Feedlot 6 Oil field water supply 9 Dewatering 12 Other (Specify below)

2 Irrigation 4 Industrial 7 Lawn and garden only 10 Observation well

Was a chemical/bacteriological sample submitted to Department? Yes No X; If yes, mo/day/yr sample was submitted

Water Well Disinfected? Yes X No

5 TYPE OF BLANK CASING USED: 5 Wrought iron 8 Concrete tile CASING JOINTS: Glued Clamped

1 Steel 3 RMP (SR) 6 Asbestos-Cement X 9 Other (specify below) Welded

2 PVC 4 ABS 7 Fiberglass galvanized pipe Threaded

Blank casing diameter 1 1/2 in. to ft., Dia in. to ft., Dia in. to ft.

Casing height above land surface 78" below in., weight lbs./ft. Wall thickness or gauge No.

TYPE OF SCREEN OR PERFORATION MATERIAL: 7 PVC 10 Asbestos-cement

1 Steel 3 Stainless steel 5 Fiberglass 8 RMP (SR) 11 Other (specify) N/A

2 Brass 4 Galvanized steel 6 Concrete tile 9 ABS 12 None used (open hole)

SCREEN OR PERFORATION OPENINGS ARE: 5 Gauzed wrapped 8 Saw cut 11 None (open hole)

1 Continuous slot 3 Mill slot 6 Wire wrapped 9 Drilled holes

2 Louvered shutter 4 Key punched 7 Torch cut 10 Other (specify)

SCREEN-PERFORATED INTERVALS: From N/A ft. to N/A ft., From ft. to ft.

From ft. to ft., From ft. to ft.

GRAVEL PACK INTERVALS: From N/A ft. to N/A ft., From ft. to ft.

From ft. to ft., From ft. to ft.

6 GROUT MATERIAL: 1 Neat cement 2 Cement grout X 3 Bentonite 4 Other

Grout intervals: From 33'6" ft. to 6'10" ft., From ft. to ft., From ft. to ft.

What is the nearest source of possible contamination:

1 Septic tank 4 Lateral lines 7 Pit privy 10 Livestock pens 14 Abandoned water well

2 Sewer lines 5 Cess pool 8 Sewage lagoon 11 Fuel storage 15 Oil well/Gas well

3 Watertight sewer lines 6 Seepage pit 9 Feedyard 12 Fertilizer storage X 16 Other (specify below) HOUSE

Direction from well? north How many feet? 0

FROM TO LITHOLOGIC LOG FROM TO LITHOLOGIC LOG

33'6" 6'10" Bentonite

6'10" 6'6" Cement

6'6" 0 Basement

RECEIVED

NOV 03 1993

BUREAU OF WATER

7 CONTRACTOR'S OR LANDOWNER'S CERTIFICATION: This water well was plugged under my jurisdiction and was

completed on (mo/day/year) November 1, 1993 and this record is true to the best of my knowledge and belief. Kansas

Water Well Contractor's License No. This Water Well Record was completed on (mo/day/yr) November 1, 1993

under the business name of ADVANCE TERMITE & PEST CONTROL, INC. by (signature) At Wells

INSTRUCTIONS: Use typewriter or ball point pen, PLEASE PRESS FIRMLY and PRINT clearly. Please fill in blanks, underline or circle the correct answers. Send to

OWNER and retain one for your records: three copies to Kansas Department of Health and Environment, Division of Environment, Environmental Geology Section, Topeka, KS 66620. Send one to WATER WELL