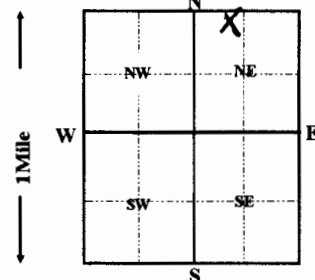


1 LOCATION OF WATER WELL: Sedgwick		FRACTION SW NE NW NE 1/4 1/4 1/4 1/4		Section Number 31 8		Township Number T 26 S 27		Range Number R 1W E/W	
Distance and direction from nearest town or city street address of well if located within city? 2104 Westfield Wichita, Kansas									
2 WATER WELL OWNER: MARRS, Monte RR#, ST. ADDRESS, BOX #: 2104 Westfield CITY, STATE, ZIP CODE: Wichita, Kansas Board of Agriculture, Division of Water Resource Application Number:									
3 LOCATE WELL'S LOCATION WITH AN "X" IN SECTION BOX: 			4 DEPTH OF COMPLETED WELL 65 ft. ELEVATION: Depth(s) groundwater Encountered 1 ft. 2 ft. 3 ft. 10/22/1992 WELL'S STATIC WATER LEVEL 20 FT. BELOW LAND SURFACE MEASURED ON mo/day/yr Pump test data: Well water was ft. after hours pumping gpm Est. Yield gpm Well water was ft. after hours pumping gpm Bore Hole Diameter 12 in. to 65 ft., and in. to ft. WELL WATER TO BE USED AS: 5 Public water supply 8 Air conditioning 11 Injection well 1 Domestic 3 Feedlot 6 Oil field water supply 9 Dewatering 12 Other (Specify below) 2 Irrigation 4 Industrial 7 Lawn and garden only 10 Monitoring well Was a chemical/bacteriological sample submitted to Department? Yes No X ; If yes, mo/day/yr sample was submitted Water Well Disinfected? Yes X No						
5 TYPE OF CASING USED: 1 Steel 3 RMP (SR) 5 Wrought iron 8 Concrete tile CASING JOINTS: Glued X Clamped 2 PVC 4 ABS 6 Asbestos-Cement 9 Other (Specify below) Welded 7 Fiberglass SDR-26 Threaded Blank casing Diameter 5 in. to 25 ft., Dia in. to ft., Dia in. to ft. Casing height above land surface 12 in., weight 2.35 lbs. / ft. Wall thickness or gauge No. .214 TYPE OF SCREEN OR PERFORATION MATERIAL: 1 Steel 3 Stainless Steel 5 Fiberglass 7 PVC 10 Asbestos-cement 2 Brass 4 Galvanized steel 6 Concrete tile 8 RMP (SR) 11 other (specify) 12 None used (open hole) SCREEN OR PERFORATION OPENING ARE: 1 Continuous slot 3 Mill slot 5 Gauzed wrapped 8 Saw cut 11 None (open hole) 2 Louvered shutter 4 Key punched 6 Wire wrapped 9 Drilled holes 7 Torch cut 10 Other (specify) SCREEN-PERFORATION INTERVALS: from 25 ft. to 65 ft., From ft. to ft. GRAVEL PACK INTERVALS: from 24 ft. to 65 ft., From ft. to ft. from ft. to ft., From ft. to ft.									
6 GROUT MATERIAL: 1 Neat cement 2 Cement grout 3 Bentonite 4 Other Grout Intervals: From 4 ft. to 24 ft., From ft. to ft., From ft. to ft. What is the nearest source of possible contamination: 1 Septic tank 4 Lateral lines 7 Pit privy 10 Livestock pens 14 Abandon water well 2 Sewer lines 5 Cess pool 8 Sewage lagoon 11 Fuel storage 15 Oil well/Gas well 3 Watertight sewer lines 6 Seepage pit 9 Feedyard 12 Fertilizer storage 16 Other (specify below) 13 Insecticide storage None Apparent Direction from well? How many feet?									
FROM TO LITHOLOGIC LOG FROM TO PLUGGING INTERVALS 0 3 topsoil 3 17 sandy clay 17 29 fine sand 29 45 medium sand (red) 45 49 clay 49 55 medium sand 55 56 clay 56 60 fine sand									
7 CONTRACTOR'S OR LANDOWNER'S CERTIFICATION: This water well was (1) constructed, (2) reconstructed, or (3) plugged under my jurisdiction and was completed on (mo/day/year) 10/22/1992 and this record is true to the best of my knowledge and belief. Kansas Water Well Contractor's License No. 236 This Water Well Record was completed on (mo/day/yr) 12/11/92 Under the business name of Harp Well & Pump Service, Inc by (signature) Jane Grederick 263									