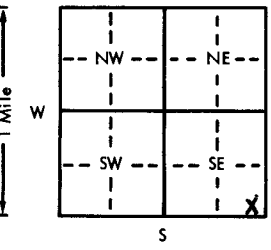
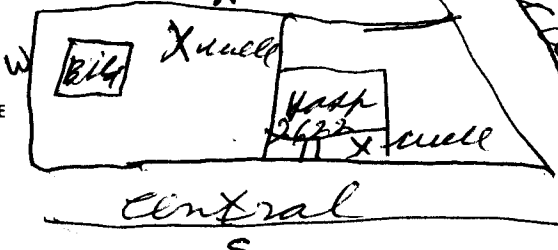


USE TYPEWRITER OR BALL
POINT PEN—PRESS FIRMLY,
PRINT CLEARLY.

WATER WELL RECORD
KSA 82a-1201-1215

Kansas Department of Health and
Environment-Division of Environment
(Water well Contractors)
Topeka, Kansas 66620

County: Sedgwick		Fraction: SE 1/4 SE 1/4 SE 1/4	Section number: 13	Township number: T 27	Range number: R 1 WEST
1. Location of well: Sedgwick			2. Distance and direction from nearest town or city:		
Street address of well location if in city: 2622 W. Central			3. Owner of well: Osteopathic Hospital R.R. or street: 2622 W. Central City, state, zip code: Wichita, Kans		
4. Locate with "X" in section below:		Sketch map:		6. Bore hole dia. 8 in. Completion date 2/67 Well depth 30 ft.	
				7. ☐ Cable tool ☐ Rotary ☐ Driven ☐ Dug ☐ Hollow rod ☐ Jetted ☒ Bored ☐ Reverse rotary	
5. Type and color of material		From	To	8. Use: ☐ Domestic ☐ Public supply ☐ Industry ☐ Irrigation ☐ Air conditioning ☐ Stock ☒ Lawn ☐ Oil field water ☐ Other	
fine Sand		0	16'	9. Casing: Material ☐ Height: Above or below Threaded ☐ Welded ☐ Surface 12 in. RMP ☐ PVC ☒ Weight 100 lbs./ft. Dia. 5 in. to 30 ft. depth Wall Thickness: inches or Dia. ☐ in. to ☐ ft. depth gage No. 116	
Coarse Sand		16'	30'	10. Screen: Manufacturer's name Sunflower Type Sawed Dia. 5" Slot/gauze Slot Length 5' Set between 25 ft. and 30 ft. ft. and ft. Gravel pack? No Size range of material 5"	
				11. Static water level: ☐ mo./day/yr. 16 1/2 ft. below land surface Date 7/21/76	
				12. Pumping level below land surfaces: ft. after hrs. pumping g.p.m. ft. after hrs. pumping g.p.m. Estimated maximum yield 30 g.p.m.	
				13. Water sample submitted: ☐ mo./day/yr. Yes ☒ No Date	
				14. Well head completion: Pitless adapter 12 Inches above grade	
				15. Well grouted? yes With: ☐ Neat cement ☐ Bentonite ☒ Concrete Depth: From 0 ft. to 10 ft.	
				16. Nearest source of possible contamination: ft. 100 Direction North Type Sewer Well disinfected upon completion? ☒ Yes ☐ No	
				17. Pump: Manufacturer's name Burkes Not installed Model number ☐ HP ☐ Volts 110 Length of drop pipe 25 ft. capacity 50 g.p.m. Type: ☐ Submersible ☐ Turbine ☐ Jet ☐ Reciprocating ☒ Centrifugal ☐ Other	
18. Elevation:		19. Remarks:		20. Water well contractor's certification:	
		None		This well was drilled under my jurisdiction and this report is true to the best of my knowledge and belief. Jet Drilling 313 Business name 257 N. Salina License No. Address Wichita, Kansas Signed Wichita, Kansas Date	

Forward the white, blue and pink copies to the Department of Health and Environment

Form WWC-5