


1	LOCATION OF WATER WELL:	Fraction	Section Number	Township Number	Range Number
County: <i>Sedgwick</i>	<i>NE 1/4 NE 1/4 SE 1/4</i>	<i>35</i>	<i>T 27 S</i>	<i>R 1 E</i>	<i>4W</i>

Distance and direction from nearest town or city street address of well if located within city?

1900 South West St. Wichita, Kansas

2 WATER WELL OWNER: *Wildcat Const. Co.* *Well No. 16*
 RR#, St. Address, Box # : *4421 W. Harry St.* Board of Agriculture, Division of Water Resources
 City, State, ZIP Code : *Wichita, KS. 67209* Application Number:

3 LOCATE WELL'S LOCATION WITH AN "X" IN SECTION BOX: 4 DEPTH OF COMPLETED WELL..... ft. ELEVATION:

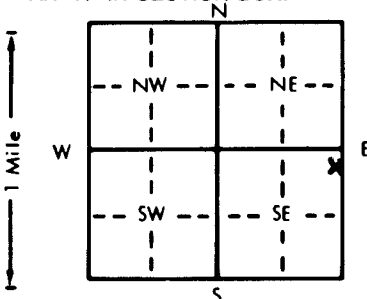

Depth(s) Groundwater Encountered 1. ft. 2. ft. 3. ft.

WELL'S STATIC WATER LEVEL ft. below land surface measured on mo/day/yr

Pump test data: Well water was ft. after hours pumping gpm

Est. Yield gpm: Well water was ft. after hours pumping gpm

Bore Hole Diameter in. to ft., and in. to ft.

WELL WATER TO BE USED AS: 5 Public water supply 8 Air conditioning 11 Injection well

1 Domestic 3 Feedlot 6 Oil field water supply 9 Dewatering 12 Other (Specify below)

2 Irrigation 4 Industrial 7 Lawn and garden only 10 Observation well

Was a chemical/bacteriological sample submitted to Department? Yes.....No.....: If yes, mo/day/yr sample was sub

mitted	Water Well Disinfected? Yes	No
--------	-----------------------------	----

5	TYPE OF BLANK CASING USED:	5 Wrought iron	8 Concrete tile	CASING JOINTS: Glued	Clamped
---	----------------------------	----------------	-----------------	----------------------	---------

1 Steel	3 BMP (SB)	6 Asbestos-Cement	9 Other (specify below)	Welded
---------	------------	-------------------	-------------------------	--------

2 PVC	4 ABS	7 Fiberglass		Threaded

Blank casing diameter _____ in. to _____ ft. Dia. _____ in. to _____ ft. Dia. _____ in. to _____ ft.

Casing height above land surface	in.	weight	lbs./ft.	Wall thickness or gauge	No.
----------------------------------	-----	--------	----------	-------------------------	-----

TYPE OF SCREEN OR PERFORATION MATERIAL: 7 PVC 10 Asbestos-cement

1 Steel	3 Stainless steel	5 Fiberglass	8 BMP (SR)	11 Other (specify)
---------	-------------------	--------------	------------	--------------------

2 Brass	4 Galvanized steel	6 Concrete tile	9 ABS	12 None used (open hole)

SCREEN OR PERFORATION OPENINGS ARE: 5 Gauzed wrapped 8 Saw cut 11 None (open hole)


2. Lowered shutter

SCREEN-PEBBLED INTERVALS: From _____ ft. to _____ ft. From _____ ft. to _____ ft.

[illegible]

GRAVEL PACK INTERVALS: From _____ ft to _____ ft From _____ ft to _____ ft

From	ft	to	ft	From	ft	to	ft
From		ft	to	ft	From	ft	to

6	GROUT MATERIAL:	1 Neat cement	2 Cement grout	3 Bentonite	4 Other
---	-----------------	---------------	----------------	-------------	---------

Grout Intervals:	From	ft to	ft	From	ft to	ft	From	ft to	ft
-------------------------	-------------	--------------	-----------	-------------	--------------	-----------	-------------	--------------	-----------

What is the nearest source of possible contamination: 10 Livestock pens 14 Abandoned water well

1 Septic tank	4 Lateral lines	7 Pit privy	10 Livestock pens	14 Abandoned water well

1 Septic tank	4 Lateral lines	7 Pit privy	11 Fuel storage	15 Oil well/gas well
2 Sewer lines	5 Cess pool	8 Sewage lagoon	12 Fertilizer storage	16 Other (specify below)

3 Watertight sewer lines	6 Seepage pit	9 Feedyard	13 Insecticide storage	

Direction from well? _____ How many feet? _____

Direction from well:		How many feet?	
FROM	TO	LITHOLOGIC LOG	LITHOLOGIC LOG
		Pulled Screen & Casing. Backfilled with clay & Bentonite from 10 Ft. to Surface.	

7 CONTRACTOR'S OR LANDOWNER'S CERTIFICATION: This water well was (1) constructed, (2) reconstructed, or (3) plugged under my jurisdiction and was completed on (mo/day/year) 11/4/85 and this record is true to the best of my knowledge and belief. Kansas

Water Well Contractor's License No. 102 This Water Well Record was completed on (mo/day/yr) 11/14/85

under the business name of Layne Western Co Wichita by (signature) [Signature]

INSTRUCTIONS: Use typewriter or ball point pen, PLEASE PRESS FIRMLY and PRINT clearly. Please fill in blanks, underline or circle the correct answers. Send top