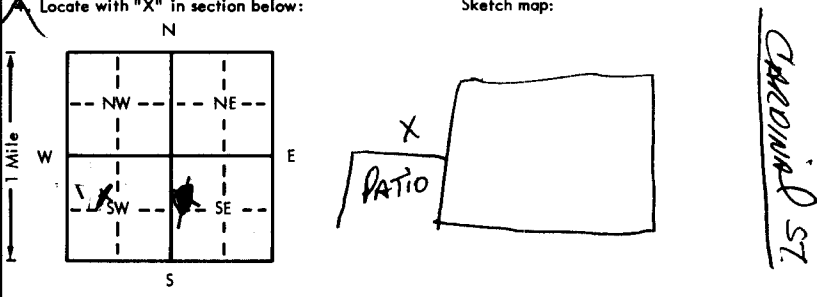


USE TYPEWRITER OR BALL
POINT PEN-PRESS FIRMLY,
PRINT CLEARLY.

WATER WELL RECORD
KSA 82a-1201-1215

Kansas Department of Health and
Environment-Division of Environment
(Water well Contractors)
Topeka, Kansas 66620

NE SE SW SE

1. Location of well:		County SEDGECWICK	Fraction SW 1/4 NW 1/4 SE 1/4	Section number 1	Township number 27 S	Range number 1 W	E/W
2. Distance and direction from nearest town or city: Street address of well location if in city: 2230 CARDINAL DR.				3. Owner of well: R.R. or street: D. HARVEY 2230 CARDINAL DR. WICHITA, KS. City, state, zip code:			
X Locate with "X" in section below:		Sketch map:		6. Bore hole dia. 8 in. Completion date 7-25-77 Well depth 40 ft.			
				7. Cable tool ☒ Rotary ☐ Driven ☐ Dig ☐ Hollow rod ☐ Jetted ☐ Bored ☐ Reverse rotary			
5. Type and color of material		From		To		8. Use: ☐ Domestic ☐ Public supply ☐ Industry ☒ Irrigation ☐ Air conditioning ☐ Stock ☒ Lawn ☐ Oil field water ☐ Other	
						9. Casing: Material SM Height: Above or below Threaded ☐ Welded ☒ Surface 12 in. RMP ☐ PVC ☐ Weight 1.5 lbs./ft. Dia. 5 in. to 40 ft. depth Wall Thickness: inches or Dia. 5 in. to 40 ft. depth gage No. 200	
						10. Screen: Manufacturer's name DEL Type 200 Dia. 5" Slot/gauze .065 Length 10' Set between 30 ft. and 40 ft. Gravel pack? ☒ Size range of material 1/4" to 1/2"	
						11. Static water level: 18 ft. below land surface Date 3-25-77	
						12. Pumping level below land surfaces: 18 ft. after 2 hrs. pumping 10 g.p.m. ft. after 4 hrs. pumping 40 g.p.m. Estimated maximum yield 40 g.p.m.	
						13. Water sample submitted: Yes ☒ No ☐ Date	
						14. Well head completion: ☐ Pitless adapter 12 inches above grade	
						X Well grouted? Yes With: ☐ Neat cement ☐ Bentonite ☒ Concrete Depth: From 12 ft. to 40 ft.	
						16. Nearest source of possible contamination: ft. 50 Direction N Type SEPTIC Well disinfected upon completion? Yes ☒ No ☐	
						17. Pump: Manufacturer's name Starline Not installed Model number 8SP681 HP 1/2 Volts 115 Length of drop pipe 35 ft. capacity 10 g.p.m. Type: ☐ Submersible ☐ Turbine ☐ Jet ☐ Reciprocating ☐ Centrifugal ☐ Other	
18. Elevation:		19. Remarks:		20. Water well contractor's certification: This well was drilled under my jurisdiction and this report is true to the best of my knowledge and belief. 2157 Elberta 129 Business name 512 W. 2157 License No. Address 512 W. 2157 Signed J. Harvey Date 4-18-77 Authorized representative			

Forward the white, blue and pink copies to the Department of Health and Environment

Form WWC-5