USE TYPEWRITER OR BALL POINT PEN-PRESS FIRMLY, PRINT CLEARLY.

WATER WELL RECORD
KSA 82a-1201-1215

Kansas Department of Health and Environment-Division of Environment
(Water well Contractors)
Topeka, Kansas 66620

SE NW NW SE

1. Location of well:	County	Fraction	Section number	Township number	Range number
	SEDGWICK	1/4 NE 1/4 SW 1/4	1	T 27 S	R 1 E (W)

2. Distonce and direction from nearest town or city: 2452 REDBUD
Street address of well location if in city: WICHITA, KANSAS

3. Owner of well: DOUG KENNY
R.R. or street: 2452 REDBUD
City, state, zip code: WICHITA, KANSAS

4. Locate with "X" in section below:

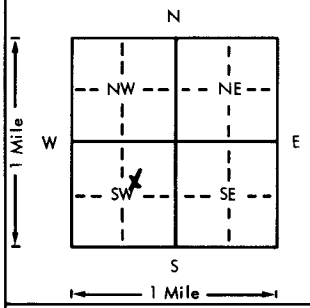

Sketch map:

6. Bore hole dia. 11 in. Completion date 9-14-76
Well depth 45 ft.

7. __ Cable tool ✓ Rotary __ Driven __ Dug
__ Hollow rod __ Jetted __ Bored __ Reverse rotary

8. Use: __ Domestic __ Public supply __ Industry
__ Irrigation __ Air conditioning __ Stock
✓ Lawn __ Oil field water __ Other

9. Casing: Material STYRENE Weight: Above or below
Threaded __ Welded GL Surface 3 in.
RMP ✓ PVC __ Weight __ lbs./ft.
Dia. 5 in. to 45 ft. depth Wall Thickness: inches or
Dia. __ in. to __ ft. depth gage No. 200

5. Type and color of material	From	To
SANDY TOPSOIL	0	4
FINE SAND	4	30
COARSE SAND	30	44
BLUE SHALE	44	45

(Use a second sheet if needed)

10. Screen: Manufacturer's name SUNFLOWER PLASTIC
Type STYRENE Dia. 5"
Slot gauze .04 Length 10'
Set between 35 ft. and 45 ft.
__ ft. and __ ft.
Gravel pack? YES Size range of material 1/4-1/2"

11. Static water level: mo./day/yr.
15 ft. below land surface Date 9-14-76

12. Pumping level below land surfaces:
__ ft. after __ hrs. pumping __ g.p.m.
__ ft. after __ hrs. pumping __ g.p.m.
Estimated maximum yield __ g.p.m.

13. Water sample submitted: mo./day/yr.
__ Yes __ No Date __

14. Well head completion: CAPPED
__ Pitless adapter 12 Inches above grade

15. Well grouted? YES
With: __ Neat cement __ Bentonite ✓ Concrete
Depth: From 40' to 14 ft.

16. Nearest source of possible contamination: CITY
ft. 75 Direction SOUTH Type SEWER
Well disinfected upon completion? ✓ Yes __ No

17. Pump: ✓ Not installed
Manufacturer's name __
Model number __ HP __ Volts __
Length of drop pipe __ ft. capacity __ g.p.m.
Type:
__ Submersible __ Turbine
__ Jet __ Reciprocating
__ Centrifugal __ Other

18. Elevation:

Topography:
__ Hill
✓ Slope
__ Upland
__ Valley

19. Remarks:

20. Water well contractor's certification:
This well was drilled under my jurisdiction and this report is true to the best of my knowledge and belief.
HARP WELL PUMP 236
Business name License No.
Address WICHITA, KANSAS
Signed M. Arnold Date 10-12-76
Authorized representative

T 27 R 1 (E) (W) Sec 1 1/4 NE 1/4 SW 1/4

Forward the white, blue and pink copies to the Department of Health and Environment

Form WWC-5

MI-1023