


|                           |          |                      |                |  |                 |              |
|---------------------------|----------|----------------------|----------------|--|-----------------|--------------|
| 1 LOCATION OF WATER WELL: |          | Fraction             | Section Number |  | Township Number | Range Number |
| County:                   | SEDGWICK | NW 1/4 NW 1/4 SW 1/4 | 3              |  | T 27 S          | R 1 W E(W)   |

Distance and direction from nearest town or city street address of well if located within city?

2558 North Ridge Road      Wichita, Kansas

|                           |                       |                                                   |
|---------------------------|-----------------------|---------------------------------------------------|
| 2] WATER WELL OWNER:      | Les Eck               |                                                   |
| RR#, St. Address, Box # : | 2558 North Ridge Road | Board of Agriculture, Division of Water Resources |
| City, State, ZIP Code :   | Wichita, KS.          | Application Number:                               |

3 LOCATE WELL'S LOCATION WITH AN "X" IN SECTION BOX: 4 DEPTH OF COMPLETED WELL: 80 ft. ELEVATION: 17

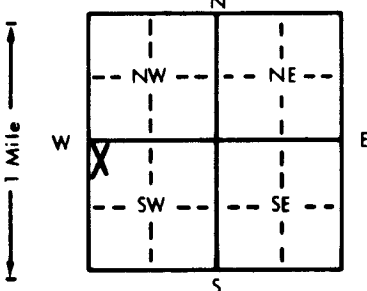

4 DEPTH OF COMPLETED WELL..... 80 ..... ft. ELEVATION: .....

Depth(s) Groundwater Encountered 1..... 17 ..... ft. 2..... ..... ft. 3..... ..... ft.

WELL'S STATIC WATER LEVEL ..... 17 ..... ft. below land surface measured on mo/day/yr ..... 6-21-88

Pump test data: Well water was ..... ft. after ..... hours pumping ..... gpm

Est. Yield ..... gpm: Well water was ..... ft. after ..... hours pumping ..... gpm

Bore Hole Diameter..... 11 ..... in. to ..... ft., and..... in. to ..... ft.

WELL WATER TO BE USED AS:

|                   |              |                          |                    |                          |
|-------------------|--------------|--------------------------|--------------------|--------------------------|
| <u>1 Domestic</u> | 3 Feedlot    | 6 Oil field water supply | 9 Dewatering       | 11 Injection well        |
| 2 Irrigation      | 4 Industrial | 7 Lawn and garden only   | 10 Monitoring well | 12 Other (Specify below) |

Was a chemical/bacteriological sample submitted to Department? Yes.....No.....**X**....; If yes, mo/day/yr sample was submitted  
Water Well Disinfected? Yes **X** No

|   |                            |            |                   |                               |   |
|---|----------------------------|------------|-------------------|-------------------------------|---|
| 5 | TYPE OF BLANK CASING USED: |            | 5 Wrought iron    | 8 Concrete tile               | CASING JOINTS: Glued . . . <u>X</u> . . . Clamped . . . . .<br>Welded . . . . .<br>Threaded . . . . . |
|   | Steel                      | 3 RMP (SR) | 6 Asbestos-Cement | 9 Other (specify below)       |   |
|   | 2 PVC                      | 4 ABS      | 7 Fiberglass      | <u>Cer-Mac styrene SDR-26</u> |   |

Blank casing diameter . . . . . 5 . . . in. to . . . . . 60 . . . ft., Dia . . . . . in. to . . . . . ft., Dia . . . . . in. to . . . . . ft.  
Casing height above land surface . . . . . 12 . . . in. weight . . . . . 1.59 . . . lbs./ft. Wall thickness or gauge No. . . . . 203

|                                         |                    |                 |                   |                          |
|-----------------------------------------|--------------------|-----------------|-------------------|--------------------------|
| TYPE OF SCREEN OR PERFORATION MATERIAL: |                    |                 | 7 PVC             | 10 Asbestos-cement       |
| 1 Steel                                 | 3 Stainless steel  | 5 Fiberglass    | <u>8 RMP (SR)</u> | 11 Other (specify) ..... |
| 2 Brass                                 | 4 Galvanized steel | 6 Concrete tile | 9 ABS             | 12 None used (open hole) |

SCREEN OR PERFORATION OPENINGS ARE:

|                    |               |                  |                          |                     |
|--------------------|---------------|------------------|--------------------------|---------------------|
| 1 Continuous slot  | 3 Mill slot   | 5 Gauzed wrapped | 8 Saw cut                | 11 None (open hole) |
| 2 Louvered shutter | 4 Key punched | 6 Wire wrapped   | 9 Drilled holes          |                     |
|                    |               | 7 Torch cut      | 10 Other (specify) ..... |                     |

|                              |      |    |        |    |           |        |     |
|------------------------------|------|----|--------|----|-----------|--------|-----|
| SCREEN-PERFORATED INTERVALS: | From | 60 | ft. to | 80 | ft., From | ft. to | ft. |
|                              | From |    | ft. to |    | ft., From | ft. to | ft. |
| GRAVEL PACK INTERVALS:       | From | 24 | ft. to | 80 | ft., From | ft. to | ft. |
|                              | From |    | ft. to |    | ft., From | ft. to | ft. |

6 GROUT MATERIAL: 1 Neat cement 2 Cement grout 3 Bentonite 4 Other

Grout Intervals: From 4 ft. to 24 ft. From ft. to ft. From ft. to ft.

What is the nearest source of possible contamination:

|                          |                 |                 |                        |                          |
|--------------------------|-----------------|-----------------|------------------------|--------------------------|
| 1 Septic tank            | 4 Lateral lines | 7 Pit privy     | 10 Livestock pens      | 14 Abandoned water well  |
| 2 Sewer lines            | 5 Cess pool     | 8 Sewage lagoon | 11 Fuel storage        | 15 Oil well/Gas well     |
| 3 Watertight sewer lines | 6 Seepage pit   | 9 Feedyard      | 12 Fertilizer storage  | 16 Other (specify below) |
|                          |                 |                 | 13 Insecticide storage | None Apparent            |

| Direction from well? | How many feet? |
|----------------------|----------------|
|                      |                |

[illegible]

7 CONTRACTOR'S OR LANDOWNER'S CERTIFICATION: This water well was (1) constructed, (2) reconstructed, or (3) plugged under my jurisdiction and was completed on (mo/day/year) 6-21-88 and this record is true to the best of my knowledge and belief. Kansas Water Well Contractor's License No. 236 This Water Well Record was completed on (mo/day/yr) 4-1-89 under the business name of Harp Well & Pump Service, Inc. by (signature) Mary Arnold