


1 LOCATION OF WATER WELL: **Sedgwick** FRACTION: **SW 1/4 NW 1/4 NW 1/4** Section Number: **3** Township Number: **T 27 S** Range Number: **R 1W EW**

Distance and direction from nearest town or city street address of well if located within city?

On Ridge Rd. & E. of Ridge Rd., S. of 29th St. (Lakeside Park) Wichita, KS.

2 WATER WELL OWNER: **CITY OF WICHITA** Board of Agriculture, Division of Water Resource
 RR#, ST. ADDRESS, BOX #: **P.O. Box 19163**
 CITY, STATE, ZIP CODE: **Wichita, Kansas 67277** Application Number:

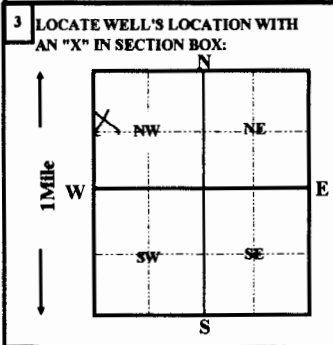

4 DEPTH OF COMPLETED WELL **25** ft. ELEVATION:
 Depth(s) groundwater Encountered **1** ft. **2** ft. **3** ft.
 WELL'S STATIC WATER LEVEL **7** FT. BELOW LAND SURFACE MEASURED ON **06/29/1994**
 Pump test data: Well water was ft. after hours pumping gpm
 Est. Yield gpm: Well water was ft. after hours pumping gpm
 Bore Hole Diameter in. to ft. and in. to ft.
 WELL WATER TO BE USED AS: **5 Public water supply** **8 Air conditioning** **11 Injection well**
1 Domestic **3 Feedlot** **6 Oil field water supply** **9 Dewatering** **12 Other (Specify below)**
2 Irrigation **4 Industrial** **7 Lawn and garden only** **10 Monitoring well**
 Was a chemical/bacteriological sample submitted to Department? Yes No ; If yes, mo/day/yr sample was submitted Water Well Disinfected? Yes No

5 TYPE OF CASING USED:
 1 Steel 3 RMP (SR) 5 Wrought iron 8 Concrete tile CASING JOINTS: Glued Clamped
 2 PVC 4 ABS 6 Asbestos-Cement 9 Other (Specify below) Welded
 7 Fiberglass Threaded
 Blank casing Diameter **5** in. to ft., Dia in. to ft., Dia in. to ft.
 Casing height below land surface **36** in., weight lbs. / ft. Wall thickness or gauge No.
 TYPE OF SCREEN OR PERFORATION MATERIAL:
 1 Steel 3 Stainless Steel 5 Fiberglass 8 RMP (SR) 11 other (specify)
 2 Brass 4 Galvanized steel 6 Concrete tile 9 ABS 12 None used (open hole)
 SCREEN OR PERFORATION OPENING ARE:
 1 Continuous slot 3 Mill slot 5 Gauzed wrapped 8 Saw cut 11 None (open hole)
 2 Louvered shutter 4 Key punched 6 Wire wrapped 9 Drilled holes
 7 Torch cut 10 Other (specify)
 SCREEN-PERFORATION INTERVALS: from ft. to ft., From ft. to ft.
 GRAVEL PACK INTERVALS: from ft. to ft., From ft. to ft.

6 GROUT MATERIAL: 1 Neat cement 2 Cement grout 3 Bentonite 4 Other
 Grout Intervals: From **2** ft. to **7** ft. From ft. to ft. From ft. to ft.
 What is the nearest source of possible contamination:
 1 Septic tank 4 Lateral lines 7 Pit privy 10 Livestock pens 14 Abandon water well
 2 Sewer lines 5 Cess pool 8 Sewage lagoon 11 Fuel storage 15 Oil well/Gas well
 3 Watertight sewer lines 6 Seepage pit 9 Feedyard 12 Fertilizer storage 16 Other (specify below)
None Apparent
 Direction from well? How many feet?

FROM	TO	LITHOLOGIC LOG	FROM	TO	PLUGGING INTERVALS
			0	2	surface silt
			2	7	cement grout
			7	10	bentonite hole plug
			10	25	chlorinated sand and gravel

7 CONTRACTOR'S OR LANDOWNER'S CERTIFICATION: This water well was (1) constructed, (2) reconstructed, or (3) plugged under my jurisdiction and was completed on (mo/day/year) **06/29/1994** and this record is true to the best of my knowledge and belief. Kansas Water Well Contractor's License No. **236** This Water Well Record was completed on (mo/day/yr) **07/06/94**
 Under the business name of **Harp Well & Pump Service, Inc** by (signature) *Jane Frederick*