

--	---	----------------------------	----------------------------------	-------------------------------

Distance and direction from nearest town or city street address of well if located within city?

223/ Tee Time Cr.

2 WATER WELL OWNER:


RR#, St. Address, Box # :

City, State, ZIP Code

Board of Agriculture, Division of Water Resources

Application Number: none

3 LOCATE WELL'S LOCATION WITH AN "X" IN SECTION BOX:

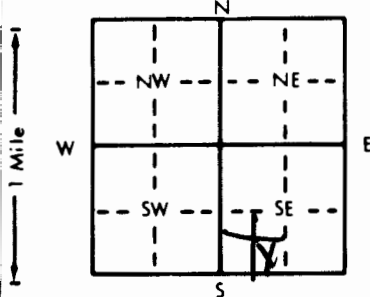

4 DEPTH OF COMPLETED WELL.....60..... ft. ELEVATION:

Depth(s) Groundwater Encountered 1. 38 ft. 2. _____ ft. 3. _____ ft.

WELL'S STATIC WATER LEVEL 38 ft. below land surface measured on mo/day/yr 6-23-91

Pump test data: Well water was ft. after hours pumping gpm

Est. Yield gpm: Well water was ft. after hours pumping gpm

Bore Hole Diameter 9 in. to 30 ft., and _____ in. to _____ ft.

WELL WATER TO BE USED AS: 5 Public water supply 8 Air conditioning 11 Injection well

1 Domestic	3 Feedlot	6 Oil field water supply	9 Dewatering	12 Other (Specify below)
------------	-----------	--------------------------	--------------	--------------------------

2 Irrigation 4 Industrial ⑦ Lawn and garden only 10 Monitoring well

Was a chemical/bacteriological sample submitted to Department? Yes.....No X.....; If yes, mo/day/yr sample was sub-

mitted Water Well Disinfected? Yes No **X**

5	TYPE OF BLANK CASING USED:
---	----------------------------

1 Steel 3 RMP (SR)
2 PVC 4 ABS

3 in. to 50 ft., Dia. in. to ft., Dia. in. to ft.

Casing height above land surface. 12 in., weight _____ lbs./ft. Wall thickness or gauge No. 160

TYPE OF SCREEN OR PERFORATION MATERIAL:

1 Steel	3 Stainless steel	5 Fiberglass	8 RMP (SR)	11 Other (specify)
2 Brass	4 Galvanized steel	6 Concrete tile	9 ABS	12 None used (open hole)

SCREEN OR PERFORATION OPENINGS ARE:

1 Continuous slot **3 Mill slot** 6 Wire wrapped 9 Drilled holes
2 Louvered shutter 4 Key punched 7 Torch cut 10 Other (specify)

SCREEN-PERFORATED INTERVALS:

From 50 ft. to 60 ft., From _____ ft. to _____ ft.

From ft. to ft., From ft. to ft.

From ft. to ft., From ft. to ft.

From	ft. to	ft., From	ft. to	ft.
------	--------	-----------	--------	-----

6	GROUT MATERIAL:
---	-----------------

1 Neat cement 2 Cement grout 3 Bentonite 4 Other

Grout Intervals: From 0 ft. to 20 ft., From _____ ft. to _____ ft., From _____ ft. to _____ ft.

What is the nearest source of possible contamination:

1 Septic tank	4 Lateral lines	7 Pit privy	11 Fuel storage	15 Oil well/Gas well
2 Sewer lines	5 Cess pool	8 Sewage lagoon	12 Fertilizer storage	16 Other (specify below)
3 Watertight sewer lines	6 Seepage pit	9 Feedyard	13 Insecticide storage	

Direction from well?

How many feet? 30

[illegible]

7 CONTRACTOR'S OR LANDOWNER'S CERTIFICATION: This water well was (1) constructed, (2) reconstructed, or (3) plugged under my jurisdiction and was

completed on (mo/day/year) 6-23-91 and this record is true to the best of my knowledge and belief. Kansas

Water Well Contractor's License No. 472 This Water Well Record was completed on (mo/day/yr) 6-23-91

under the business name of Bearden Pumps & Well Services by (signature) David R Beahm

INSTRUCTIONS: Use typewriter or ball point pen. PLEASE PRESS FIRMLY and PRINT clearly. Please fill in blanks, underline or circle the correct answers. Send top three copies to Kansas Department of Health and Environment, Bureau of Water, Topeka, Kansas 66620-7320. Telephone: 913-296-5545. Send one to WATER WELL OWNER and retain one for your records.