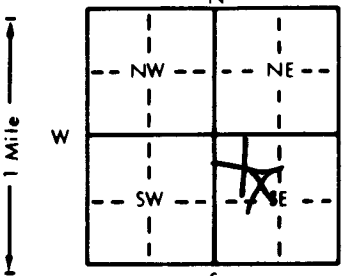


1 LOCATION OF WATER WELL:		Fraction	Section Number	Township Number	Range Number
County: <u>Bedford</u>		<u>1/4 NW 1/4 SE 1/4</u>	<u>4</u>	T <u>27</u> S	R <u>1</u> <u>EW</u>
Distance and direction from nearest town or city street address of well if located within city? <u>2323 Tee Time Ct</u>					
2 WATER WELL OWNER: <u>Mrs. Isaac</u>					
RR#, St. Address, Box #: <u>2323 Tee Time Ct</u>					
City, State, ZIP Code: <u>Wichita Kan</u>					
Board of Agriculture, Division of Water Resources					
Application Number: <u>none</u>					
3 LOCATE WELL'S LOCATION WITH AN "X" IN SECTION BOX:		4 DEPTH OF COMPLETED WELL: <u>53</u> ft. ELEVATION: <u>1300</u>			
		Depth(s) Groundwater Encountered 1. <u>29</u> ft. 2. <u>29</u> ft. 3. <u>29</u> ft.			
		WELL'S STATIC WATER LEVEL <u>29</u> ft. below land surface measured on mo/day/yr <u>2-28-91</u>			
		Pump test data: Well water was _____ ft. after _____ hours pumping _____ gpm			
		Est. Yield _____ gpm: Well water was _____ ft. after _____ hours pumping _____ gpm			
		Bore Hole Diameter: <u>9</u> in. to <u>20</u> in. to _____ in. to _____ in.			
		WELL WATER TO BE USED AS: 5 Public water supply 8 Air conditioning 11 Injection well			
		1 Domestic 3 Feedlot 6 Oil field water supply 9 Dewatering 12 Other (Specify below)			
		2 Irrigation 4 Industrial <u>7</u> Lawn and garden only 10 Monitoring well			
		Was a chemical/bacteriological sample submitted to Department? Yes _____ No <u>X</u> If yes, mo/day/yr sample was submitted _____			
		Water Well Disinfected? Yes _____ No <u>X</u>			
5 TYPE OF BLANK CASING USED:					
1 Steel 3 RMP (SR) 5 Wrought iron 8 Concrete tile CASING JOINTS: Glued <u>X</u> Clamped _____					
2 PVC 4 ABS 6 Asbestos-Cement 9 Other (specify below) Welded _____					
3 Fiberglass _____ Threaded _____					
Blank casing diameter <u>5.56</u> in. to <u>43</u> in. to _____ in. to _____ in. Dia _____ in. to _____ in. Dia _____ in. to _____ in.					
Casing height above land surface <u>12</u> in. weight _____ lbs./ft. Wall thickness or gauge No. _____					
TYPE OF SCREEN OR PERFORATION MATERIAL:					
1 Steel 3 Stainless steel 5 Fiberglass 7 PVC 10 Asbestos-cement					
2 Brass 4 Galvanized steel 6 Concrete tile 8 RMP (SR) 11 Other (specify) _____					
9 ABS 12 None used (open hole)					
SCREEN OR PERFORATION OPENINGS ARE:					
1 Continuous slot 3 Mill slot 5 Gauzed wrapped 8 Saw cut 11 None (open hole)					
2 Louvered shutter 4 Key punched 6 Wire wrapped 9 Drilled holes					
7 Torch cut 10 Other (specify) _____					
SCREEN-PERFORATED INTERVALS: From <u>43</u> ft. to <u>53</u> ft. From _____ ft. to _____ ft.					
From _____ ft. to _____ ft. From _____ ft. to _____ ft.					
GRAVEL PACK INTERVALS: From _____ ft. to _____ ft. From _____ ft. to _____ ft.					
From _____ ft. to _____ ft. From _____ ft. to _____ ft.					
6 GROUT MATERIAL: 1 Neat cement 2 Cement grout 3 Bentonite 4 Other _____					
Grout Intervals: From <u>0</u> ft. to <u>20</u> ft. From _____ ft. to _____ ft. From _____ ft. to _____ ft.					
What is the nearest source of possible contamination:					
1 Septic tank 4 Lateral lines 7 Pit privy 10 Livestock pens 14 Abandoned water well					
2 Sewer lines 5 Cess pool 8 Sewage lagoon 11 Fuel storage 15 Oil well/Gas well					
3 Watertight sewer lines 6 Seepage pit 9 Feedyard 12 Fertilizer storage 16 Other (specify below) _____					
13 Insecticide storage _____					
Direction from well? <u>East</u> How many feet? <u>20</u>					
FROM		TO		LITHOLOGIC LOG	
FROM		TO		PLUGGING INTERVALS	
<u>0</u>		<u>10</u>		<u>Top Soil</u>	
<u>10</u>		<u>29</u>		<u>Fine Tan Sand</u>	
<u>29</u>		<u>53</u>		<u>Coarse Tan Sand</u>	
7 CONTRACTOR'S OR LANDOWNER'S CERTIFICATION: This water well was <u>(1)</u> constructed, (2) reconstructed, or (3) plugged under my jurisdiction and was completed on (mo/day/year) <u>2-28-91</u> and this record is true to the best of my knowledge and belief. Kansas Water Well Contractor's License No. <u>473</u> This Water Well Record was completed on (mo/day/yr) <u>2-28-91</u> under the business name of <u>Bearden Pump & Well Ser.</u> by (signature) <u>Davis R Bearden</u>					
INSTRUCTIONS: Use typewriter or ball point pen. PLEASE PRESS FIRMLY and PRINT clearly. Please fill in blanks, underline or circle the correct answers. Send top three copies to Kansas Department of Health and Environment, Bureau of Water, Topeka, Kansas 66620-7320. Telephone: 913-296-5545. Send one to WATER WELL OWNER and retain one for your records.					