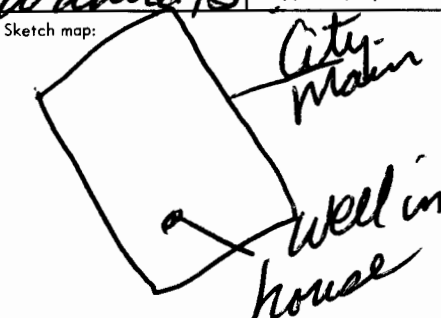


USE TYPEWRITER OR BALL
POINT PEN-PRESS FIRMLY,
PRINT CLEARLY.

WATER WELL RECORD
KSA 82a-1201-1215

Kansas Department of Health and
Environment-Division of Environment
(Water well Contractors)
Topeka, Kansas 66620

1. Location of well: County <u>Sedgwick</u> Fraction <u>SW 1/4 NE 1/4 SE 1/4</u> Section number <u>7</u> Township number <u>T 27 S</u> Range number <u>R 1 E</u>	
2. Distance and direction from nearest town or city: Street address of well location if in city: <u>1710 Mesa Ct. Wichita KS</u>	
3. Owner of well: <u>Ken Rube Const</u> R.R. or street: <u>21821 Appaloosa Ct.</u> City, state, zip code: <u>Goodland KS 67052</u>	
4. Locate with "X" in section below: Sketch map: 	
6. Bore hole dia. <u>5 1/2</u> in. Completion date <u>10/1/78</u> Well depth <u>50</u> ft.	
7. ☒ Cable tool ☒ Rotary ☐ Driven ☐ Dug ☐ Hollow rod ☐ Jetted ☐ Bored ☐ Reverse rotary	
8. Use: ☐ Domestic ☐ Public supply ☐ Industry ☐ Irrigation ☐ Air conditioning ☐ Stock ☒ Lawn ☐ Oil field water ☐ Other	
9. Casing: Material <u>Steel</u> Height <u>12</u> Above or below Threading <u>Welded</u> Surface <u>1 1/2</u> in. RMP <u>K</u> PVC <u>1.50</u> lbs./ft. Dia. <u>5 1/2</u> in. to <u>50</u> ft. depth Wall Thickness <u>1.200</u> inches or gage No. <u>200</u>	
10. Screen: Manufacturer's name <u>Sunflower</u> Type <u>200</u> Dia. <u>5 1/2</u> Slot gauze <u>1/16</u> Length <u>10 ft</u> Set between <u>40</u> ft. and <u>50</u> ft. Gravel pack? <u>Yes</u> Size range of material <u>3/8</u>	
11. Static water level: <u>22</u> ft. below land surface Date <u>10/1/78</u>	
12. Pumping level below land surfaces: <u>22</u> ft. after <u>12</u> hrs. pumping <u>20</u> g.p.m. <u>22</u> ft. after <u>12</u> hrs. pumping <u>20</u> g.p.m. Estimated maximum yield <u>50-75</u> g.p.m.	
13. Water sample submitted: <u>Yes</u> ☒ No ☐ Date <u>10/1/78</u>	
14. Well head completion: <u>Pitless adapter</u> <u>12</u> inches above grade	
15. Well grouted? <u>Yes</u> With: <u>Neat cement</u> <u>Bentonite</u> ☒ Concrete Depth: From <u>6</u> ft. to <u>16</u> ft.	
16. Nearest source of possible contamination: <u>40</u> ft. Direction <u>No.</u> Type <u>City-main</u> Well disinfected upon completion? ☒ Yes ☐ No	
17. Pump: ☒ Not installed Manufacturer's name <u>Ken Rube Const</u> Model number <u>318</u> HP <u>1</u> Volts <u>115</u> Length of drop pipe <u>50</u> ft. capacity <u>20</u> g.p.m. Type: ☐ Submersible ☐ Turbine ☐ Jet ☐ Reciprocating ☐ Centrifugal ☐ Other	
18. Elevation: Topography: ☒ Hill ☐ Slope ☒ Upland ☐ Valley	
19. Remarks: (Use a second sheet if needed)	
20. Water well contractor's certification: This well was drilled under my jurisdiction and this report is true to the best of my knowledge and belief. Business name <u>Ken Rube Const</u> License No. <u>318</u> Address <u>21821 Appaloosa Ct.</u> City <u>Goodland</u> State <u>KS</u> Date <u>10/1/78</u> Authorized representative <u>Ken Rube</u>	

Forward the white, blue and pink copies to the Department of Health and Environment

Form WWC-5