


1	LOCATION OF WATER WELL: County: <u>Selawick</u>	Fraction <u>SW</u> $\frac{1}{4}$ <u>SW</u> $\frac{1}{4}$ <u>NW</u> $\frac{1}{4}$	Section Number <u>8</u>	Township Number T <u>27</u> S	Range Number R <u>1</u> E <u>W</u>
---	--	---	----------------------------	----------------------------------	---------------------------------------

Distance and direction from nearest town or city street address of well if located within city?

10246 West Port
2 WATER WELL OWNER: Mr. Smith
RR#, St. Address, Box #: 10246 West Port
City, State, ZIP Code: Wichita Kansas 67212
Board of Agriculture, Division of Water Resources
Application Number: none

3 LOCATE WELL'S LOCATION WITH AN "X" IN SECTION BOX: 4 DEPTH OF COMPLETED WELL: 45 ft. ELEVATION: 1300
Depth(s) Groundwater Encountered 1. 27 ft. 2. ft. 3. ft.

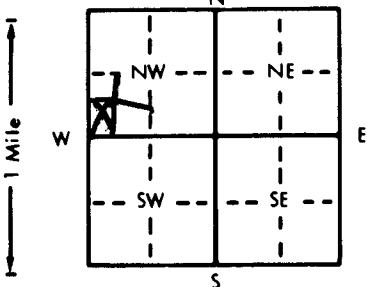

WELL'S STATIC WATER LEVEL 27 ft. below land surface measured on mo/day/yr 3-25-92

Pump test data: Well water was _____ ft. after _____ hours pumping _____ gpm

Est. Yield _____ gpm: Well water was _____ ft. after _____ hours pumping _____ gpm

Bore Hole Diameter 9 in. to 20 ft., and _____ in. to _____ ft.

WELL WATER TO BE USED AS:

1 Domestic	3 Feedlot	6 Oil field water supply	9 Dewatering	11 Injection well
2 Irrigation	4 Industrial	7 <u>Lawn and garden only</u>	10 Monitoring well	12 Other (Specify below)

Was a chemical/bacteriological sample submitted to Department? Yes _____ No X; If yes, mo/day/yr sample was submitted _____

Water Well Disinfected? Yes _____ No X

5	TYPE OF BLANK CASING USED:	5 Wrought iron	8 Concrete tile	CASING JOINTS: Glued ☒ Clamped ☐
	1 Steel	3 RMP (SR)	6 Asbestos-Cement	9 Other (specify below)
				Welded ☐

Blank casing diameter 5 in. to 35 ft., Dia. 2 PVC 4 ABS 7 Fiberglass Threaded.

Casing height above land surface 12 in. weight 160 lbs./ft. Wall thickness or gauge No. 160

TYPE OF SCREEN OR PERFORATION MATERIAL:			⑦ PVC	10 Asbestos-cement
1 Steel	3 Stainless steel	5 Fiberglass	8 RMP (SR)	11 Other (specify)
2 Brass	4 Galvanized steel	6 Concrete tile	9 ABS	12 None used (open hole)

SCREEN OR PERFORATION OPENINGS ARE:

1 Continuous slot	3 Mill slot	5 Gauzed wrapped	8 Saw cut	11 None (open hole)
2 Louvered shutter	4 Key punched	6 Wire wrapped	9 Drilled holes	
		7 Torch cut	10 Other (specify)	

SCREEN-PERFORATED INTERVALS: From 33 ft. to 43 ft., From ft. to ft.
From ft. to ft., From ft. to ft.
GRAVEL PACK INTERVALS: From ft. to ft., From ft. to ft.
none From ft. to ft., From ft. to ft.

6 GROUT MATERIAL: 1 Neat cement 2 Cement grout 3 Bentonite 4 Other

Grout intervals: From 0 ft. to 20 ft. From ft. to ft. From ft. to ft.

What is the nearest source of possible contamination:

1 Septic tank	4 Lateral lines	7 Pit privy	10 Livestock pens	14 Abandoned water well
2 Sewer lines	5 Cess pool	8 Sewage lagoon	11 Fuel storage	15 Oil well/Gas well
3 Watertight sewer lines	6 Seepage pit	9 Feedyard	12 Fertilizer storage	16 Other (specify below)

Direction from well? *West*

How many feet? *15*

[illegible]

7. CONTRACTOR'S OR LANDOWNER'S CERTIFICATION: This water well was (1) constructed, (2) reconstructed, or (3) plugged under my jurisdiction and was completed on (mo/day/year) 3-25-92 and this record is true to the best of my knowledge and belief. Kansas Water Well Contractor's License No. 472 This Water Well Record was completed on (mo/day/yr) 3-25-92 under the business name of Barclay Pump & Well by (signature) David R. Barclay