WATER WELL RECORD Form WWC-5 KSA 82a-1212

1 LOCATION OF WATER WELL: County: Sedgwick | Fraction: SW ¼ SW ¼ SW ¼ | Section Number: 8 | Township Number: T 27 S | Range Number: R 1 E/W

Distance and direction from nearest town or city street address of well if located within city?
180' N of NE corner of 13th Street and Maize Road; Wichita, KS Amoco #2126 50885093 MW-2

2 WATER WELL OWNER: Groundwater Management Section, Amoco Corporation
RR#, St. Address, Box # : 4502 E. 41st Street
City, State, ZIP Code : Tulsa, OK 74135
Board of Agriculture, Division of Water Resources Application Number:

3 LOCATE WELL'S LOCATION WITH AN "X" IN SECTION BOX:

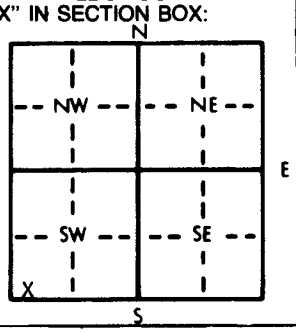

4 DEPTH OF COMPLETED WELL: 32 ft. ELEVATION: Approx. Surface Elev.: 1345
Depth(s) Groundwater Encountered 1. 22 ft. 2. ft. 3. ft.
WELL'S STATIC WATER LEVEL 23.8 ft. below land surface measured on mo/day/yr 8/8/88
Pump test data: Well water was ft. after hours pumping gpm
Est. Yield N/A gpm: Well water was ft. after hours pumping gpm
Bore Hole Diameter 7 in. to 32 ft., and in. to ft.
WELL WATER TO BE USED AS: 1 Domestic 2 Irrigation 3 Feedlot 4 Industrial 5 Public water supply 6 Oil field water supply 7 Lawn and garden only 8 Air conditioning 9 Dewatering (10) Monitoring well 11 Injection well 12 Other (Specify below)
Was a chemical/bacteriological sample submitted to Department? Yes ..... No X; If yes, mo/day/yr sample was submitted
Water Well Disinfected? Yes No X

5 TYPE OF BLANK CASING USED: 1 Steel (2) PVC 3 RMP (SR) 4 ABS 5 Wrought iron 6 Asbestos-Cement 7 Fiberglass 8 Concrete tile 9 Other (specify below)
CASING JOINTS: Glued Clamped Welded Threaded X
Blank casing diameter 2 in. to 17 ft., Dia in. to ft., Dia in. to ft.
Casing height above land surface 39 in., weight lbs./ft. Wall thickness or gauge No. Schedule 40
TYPE OF SCREEN OR PERFORATION MATERIAL: 1 Steel 2 Brass 3 Stainless steel 4 Galvanized steel 5 Fiberglass 6 Concrete tile (7) PVC 8 RMP (SR) 9 ABS 10 Asbestos-cement 11 Other (specify) 12 None used (open hole)
SCREEN OR PERFORATION OPENINGS ARE: 1 Continuous slot (3) Mill slot 2 Louvered shutter 4 Key punched 5 Gauzed wrapped 6 Wire wrapped 7 Torch cut 8 Saw cut 9 Drilled holes 10 Other (specify) 11 None (open hole)
SCREEN-PERFORATED INTERVALS: From 17 ft. to 32 ft., From ft. to ft.
From ft. to ft., From ft. to ft.
GRAVEL PACK INTERVALS: From 16 ft. to 32 ft., From ft. to ft.
From ft. to ft., From ft. to ft.

6 GROUT MATERIAL: 1 Neat cement 2 Cement grout (3) Bentonite 4 Other
Grout Intervals: From 13.5 ft. to 16 ft., From ft. to ft., From ft. to ft.
What is the nearest source of possible contamination: 1 Septic tank 2 Sewer lines 3 Watertight sewer lines 4 Lateral lines 5 Cess pool 6 Seepage pit 7 Pit privy 8 Sewage lagoon 9 Feedyard 10 Livestock pens (11) Fuel storage 12 Fertilizer storage 13 Insecticide storage 14 Abandoned water well 15 Oil well/Gas well 16 Other (specify below)
Direction from well? South How many feet? 100

FROM	TO	LITHOLOGIC LOG	FROM	TO	PLUGGING INTERVALS
0	9	Brown Silty Lean Clay			
9	19	Red-Brown Fine to Medium Sand			
19	30	Yellow-Red-Brown Medium Sand			
30	32	Gray-Red Coarse Sand			
		Casing/Screen were removed and well was plugged with cement-bentonite			
		grout to 22 feet on 9/12/88.			

7 CONTRACTOR'S OR LANDOWNER'S CERTIFICATION: This water well was (1) constructed, (2) reconstructed, or (3) plugged under my jurisdiction and was completed on (mo/day/year) 8/01/88 9/12/88 and this record is true to the best of my knowledge and belief. Kansas Water Well Contractor's License No. 416 This Water Well Record was completed on (mo/day/yr) 10-10-88
under the business name of Terracon Consultants INC by (signature)

INSTRUCTIONS: Use typewriter or ball point pen. *PLEASE PRESS FIRMLY* and *PRINT* clearly. Please fill in blanks, underline or circle the correct answers. Send top three copies to Kansas Department of Health and Environment, Bureau of Water Protection, Topeka, Kansas 66620-7320. Telephone: 913-296-5514. Send one to WATER WELL OWNER and retain one for your records.

OFFICE USE ONLY T R E/W SEC. ¼ ¼ ¼