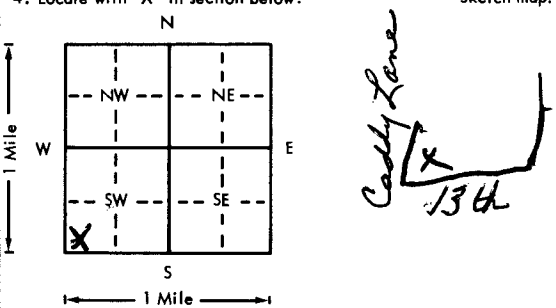


USE TYPEWRITER OR BALL
POINT PEN-PRESS FIRMLY,
PRINT CLEARLY.

WATER WELL RECORD
KSA 82a-1201-1215

Kansas Department of Health and
Environment-Division of Environment
(Water well Contractors)
Topeka, Kansas 66620

1. Location of well: Sedgewick		Fraction: SW 1/4 SW 1/4 SW 1/4		Section number: 8		Township number: T 27 S R 1 E	
2. Distance and direction from nearest town or city: Street address of well location if in city: 1440 Caddy Lane				3. Owner of well: Ron Anderson R.R. or street: 1440 Caddy Lane City, state, zip code: Wichita KS 67212			
4. Locate with "X" in section below: 				6. Bore hole dia. 8 in. Completion date: 10/7/77 Well depth 35 ft.			
5. Type and color of material				7. ☒ Cable tool ☒ Rotary ☐ Driven ☐ Dug ☐ Hollow rod ☐ Jetted ☐ Bored ☐ Reverse rotary			
				8. Use: ☒ Domestic ☐ Public supply ☐ Industry ☐ Irrigation ☐ Air conditioning ☐ Stock ☐ Lawn ☐ Oil field water ☐ Other			
				9. Casing: Material: Styrene Height: 60 ft. or below Threaded ☐ Welded ☐ Surface 12 in. RMP ☒ PVC ☐ Weight 100 lbs./ft. Dia. 4 in. to 35 ft. depth Wall Thickness: inches or Dia. ☐ in. to ☐ ft. depth gage No. 100			
				10. Screen: Manufacturer's name: Sunflower Type 100 Dia. 4 Slot/gauze Slot Length 35 Set between 30 ft. and 35 ft. None ft. and None ft. Gravel pack None Size range of material None			
				11. Static water level: 25 ft. below land surface Date: 10/7/77			
				12. Pumping level below land surfaces: ____ ft. after ____ hrs. pumping ____ g.p.m. ____ ft. after ____ hrs. pumping ____ g.p.m. Estimated maximum yield 5 g.p.m.			
				13. Water sample submitted: ____ mo./day/yr. ____ Yes ☒ No Date ____			
				14. Well head completion: ____ Pitless adapter ____ Inches above grade			
				15. Well grouted? No With: ☒ Neat cement ☐ Bentonite ☐ Concrete Depth: From ____ ft. to ____ ft.			
				16. Nearest source of possible contamination: ft. 50 Direction N Type sewer Well disinfected upon completion? ☒ Yes ☐ No			
				17. Pump: ☒ Not installed Manufacturer's name ____ Model number ____ HP ____ Volts ____ Length of drop pipe ____ ft. capacity ____ g.p.m. Type: ☐ Submersible ☐ Turbine ☐ Jet ☐ Reciprocating ☐ Centrifugal ☐ Other			
18. Elevation:		19. Remarks: Well not completed. was destroyed by owner. New well was drilled 48' Refer to next log. This well was checked by me Oct 4 - 1977 Ron Anderson		20. Water well contractor's certification: This well was drilled under my jurisdiction and this report is true to the best of my knowledge and belief. Jet Drilling 313 Business name 257 N Sabin License No. ____ Address Wichita KS Signed Ron Anderson Date 10/7/77 Authorized representative			

Forward the white, blue and pink copies to the Department of Health and Environment

Form WWC-5