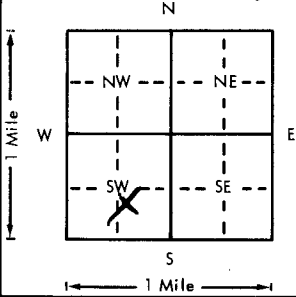
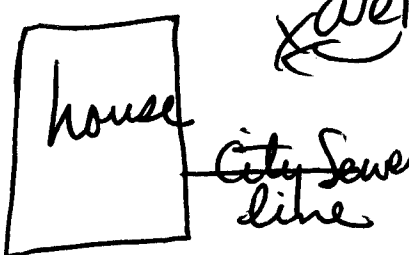


USE TYPEWRITER OR BALL
POINT PEN-PRESS FIRMLY,
PRINT CLEARLY.

WATER WELL RECORD
KSA 82a-1201-1215

Kansas Department of Health and
Environment-Division of Environment
(Water well Contractors)
Topeka, Kansas 66620

1. Location of well: <u>Edgwick</u>		Fraction: <u>NW 1/4 SE 1/4 SW 1/4</u>	Section number: <u>8</u>	Township number: <u>27</u> S <u>R</u> E	Range number: <u>1</u> E
2. Distance and direction from nearest town or city: Street address of well location in city: <u>1502 Valley View Ct. Wichita</u>		3. Owner of well: <u>Jay Russell</u> R.R. or street: <u>156 No. Main Rd #34</u> City, state, zip code: <u>Wichita, KS 67212</u>			
4. Locate with "X" in section below: 		Sketch map: 		6. Bore hole dia. <u>4</u> in. Completion date: <u>2/27/79</u> Well depth: <u>60</u> ft.	
5. Type and color of material		From	To	7. ☒ Cable tool ☒ Rotary ☐ Driven ☐ Dug ☐ Hollow rod ☐ Jetted ☐ Bored ☐ Reverse rotary	
Top soil		0	3	8. Use: ☐ Domestic ☐ Public supply ☐ Industry ☐ Irrigation ☐ Air conditioning ☐ Stock ☒ Lawn ☐ Oil field water ☐ Other	
Red clay		3	15	9. Casing: Material <u>Steel</u> Height: Above or below Threaded ☐ Welded ☒ Surface <u>92</u> in. RMP ☒ PVC ☐ Weight <u>150</u> lbs./ft.	
fine sand.		15	27	Dia. <u>5</u> in. to <u>60</u> ft. depth Wall Thickness: inches or Dia. <u>5</u> in. to <u>60</u> ft. depth Gauge No. <u>1200</u>	
Blue-green clay		27	29	10. Screen: Manufacturer's name <u>Sumflow</u> Type <u>100</u> Dia. <u>5</u> in. Slot gauge <u>1/16</u> Length <u>10</u> ft.	
med to coarse gravel		29	58	Set between <u>50</u> ft. and <u>60</u> ft. Gravel pack? ☒ Size range of material <u>3/8</u>	
gray clay.		58	60	11. Static water level: <u>22</u> ft. below land surface Date <u>2/27/79</u> 12. Pumping level below land surfaces: <u>26</u> ft. after <u>12</u> hrs. pumping <u>15</u> g.p.m. <u>38</u> ft. after <u>2</u> hrs. pumping <u>50-80</u> g.p.m. Estimated maximum yield <u>50-80</u> g.p.m.	
				13. Water sample submitted: <u>2/27/79</u> mo./day/yr. ☐ Yes ☒ No Date	
				14. Well head completion: ☐ Pitless adapter <u>12</u> inches above grade	
				15. Well grouted? <u>yes</u> With: ☐ Neat cement ☐ Bentonite ☒ Concrete Depth: From <u>27</u> ft. to <u>12</u> ft.	
				16. Nearest source of possible contamination <u>30</u> ft. Direction <u>South</u> Type <u>line</u> Well disinfected upon completion? ☐ Yes ☐ No	
				17. Pump: ☒ Not installed Manufacturer's name _____ Model number _____ HP _____ Volts _____ Length of drop pipe _____ ft. capacity _____ g.p.m. Type: ☐ Submersible ☐ Turbine ☐ Jet ☐ Reciprocating ☐ Centrifugal ☐ Other	
18. Elevation:		19. Remarks:			
Topography: ☐ Hill ☐ Slope ☐ Upland ☐ Valley		(Use a second sheet if needed)			
		20. Water well contractor's certification: This well was drilled under my jurisdiction and this report is true to the best of my knowledge and belief. <u>Whisper Valley 318</u> Business name <u>Edgwick</u> License No. _____ Address _____ Signature <u>[Signature]</u> Date <u>2/27/79</u> Authorized representative			

Forward the white, blue and pink copies to the Department of Health and Environment

Form WWC-5