USE TYPEWRITER OR BALL POINT PEN-PRESS FIRMLY, PRINT CLEARLY.

WATER WELL RECORD
KSA 82a-1201-1215

Kansas Department of Health and Environment-Division of Environment
(Water well Contractors)
Topeka, Kansas 66620

1. Location of well:	County	Fraction	Section number	Township number	Range number
	Sedgwick	NE 1/4 SE 1/4 NE 1/4	9	T 27 S	R 1 W E (W)

2. Distance and direction from nearest town or city:

Street address of well location if in city: 7229 Bittersweet

3. Owner of well: Lloyd Const Co
R.R. or street: 1935 N. Ridge Rd.
City, state, zip code: Wichita KS 67212

4. Locate with "X" in section below:

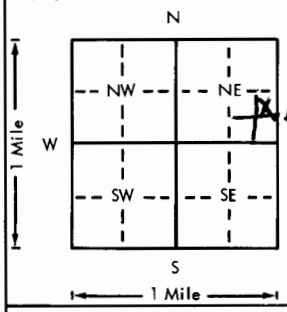

Sketch map:

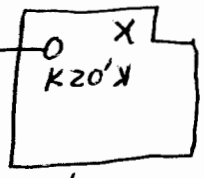

in Basement

6. Bore hole dia. 9 in. Completion date 5-3-77
Well depth 28-6 ft.

7. __ Cable tool __ Rotary __ Driven __ Dug
__ Hollow rod __ Jetted X Bored __ Reverse rotary

8. Use: X Domestic __ Public supply __ Industry
__ Irrigation __ Air conditioning __ Stock
__ Lawn __ Oil field water __ Other

9. Casing: Material [redacted] Height: Above or below
Threaded ___ Welded Gld Surface 14 in.
RMP X PVC ___ Weight ___ lbs./ft.
Dia. 6 in. to 0 ft. depth Wall Thickness: inches or
Dia. 6 in. to 28-6 ft. depth gage No. 20 DWB

10. Screen: Manufacturer's name Sunflower Mfg. Co.
Type ~~PVC~~ RMP Dia. 6"
Slot/gauze 3/16 Length 5 ft
Set between 23-6 ft. and 28-6 ft.
___ ft. and ___ ft.
Gravel pack? No Size range of material ___

11. Static water level: mo./day/yr.
18 ft. below land surface Date 5/3/77

12. Pumping level below land surfaces:
___ ft. after ___ hrs. pumping ___ g.p.m.
___ ft. after ___ hrs. pumping ___ g.p.m.
Estimated maximum yield 50 g.p.m.

13. Water sample submitted: mo./day/yr.
___ Yes X No Date ___

14. Well head completion:
___ Pitless adapter 14 Inches above grade

15. Well grouted? X
With: ___ Neat cement ___ Bentonite X Concrete
Depth: From 0 ft. to 10 ft.

16. Nearest source of possible contamination: Sump
ft. 20 Direction West Type Pump
Well disinfected upon completion? X Yes ___ No

17. Pump: X Not installed
Manufacturer's name ___
Model number ___ HP ___ Volts ___
Length of drop pipe ___ ft. capacity ___ g.p.m.
Type:
___ Submersible ___ Turbine
___ Jet ___ Reciprocating
___ Centrifugal ___ Other

5. Type and color of material

	From	To
Red Sand Med. Fine	0	6
" " Fine	6	10
Drk. Gray Clay	10	10-6
Lt. Tan Fine Sand	10-6	16-6
Lt. Brn. Med. Course gravel	16-6	28-6
Blue/Green Clay	28-6	??

(Use a second sheet if needed)

18. Elevation:

Topography:
___ Hill
___ Slope
X Upland
___ Valley

19. Remarks: well in Basement

20. Water well contractor's certification:
This well was drilled under my jurisdiction and this report is true to the best of my knowledge and belief.
Protheroe Pump & Well 295
Business name License No.
Address 8227 W 27th So.
Signed [signature] Date 5/5/77
Authorized representative

T 27 — R 1 (W) — Sec 9 — 1/4 NE 1/4 NE 1/4

Forward the white, blue and pink copies to the Department of Health and Environment

Form WWC-5

MI-1023