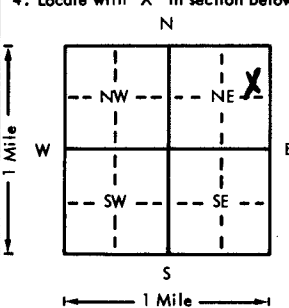


USE TYPEWRITER OR BALL
POINT PEN-PRESS FIRMLY,
PRINT CLEARLY.

WATER WELL RECORD
KSA 82a-1201-1215

Kansas Department of Health and
Environment-Division of Environment
(Water well Contractors)
Topeka, Kansas 66620

1. Location of well:		County <u>Sedg</u>	Fraction <u>SE 1/4 NE 1/4 NE 1/4</u>	Section number <u>9</u>	Township number <u>T 27 S</u>	Range number <u>R 1 E</u>
2. Distance and direction from nearest town or city: Street address of well location if in city: <u>7237 W. 18th Wichita</u>				3. Owner of well: <u>Hershel Grier</u> R.R. or street: <u>7237 W. 18th</u> City, state, zip code: <u>Wichita, KS.</u>		
4. Locate with "X" in section below: Sketch map: 				6. Bore hole dia. <u>10</u> in. Completion date <u>2/3/76</u> Well depth <u>65</u> ft. 7. ☒ Cable tool ☒ Rotary ☐ Driven ☐ Dug ☐ Hollow rod ☐ Jetted ☐ Bored ☐ Reverse rotary		
5. Type and color of material				8. Use: ☒ Domestic ☐ Public supply ☐ Industry ☐ Irrigation ☐ Air conditioning ☐ Stock ☐ Lawn ☐ Oil field water ☐ Other		
				9. Casing: Material <u>Plst</u> Height: Above or below Threaded ☐ Welded ☒ Surface <u>12</u> in. RMP ☐ PVC ☒ Weight <u>2.00</u> lbs./ft. Dia <u>5</u> in. to <u>65</u> ft. depth Wall Thickness: inches Dia. <u>5</u> in. to <u>65</u> ft. depth gage No. <u>190</u>		
				10. Screen: Manufacturer's name <u>JL</u> Type <u>Plst</u> Dia. <u>5 in</u> Slot gauge <u>1/16</u> Length <u>10 ft</u> Set between <u>55</u> ft. and <u>65</u> ft. Gravel pack? <u>Yes</u> Size range of material <u>1/2-3/8</u>		
				11. Static water level: <u>16</u> ft. below land surface Date <u>2/3/76</u>		
				12. Pumping level below land surfaces: <u>18</u> ft. after <u>1</u> hrs. pumping <u>20</u> g.p.m. <u>18</u> ft. after <u>1</u> hrs. pumping <u>20</u> g.p.m. Estimated maximum yield <u>100</u> g.p.m.		
				13. Water sample submitted: <u>Yes</u> ☒ No ☐ Date <u>2/3/76</u>		
				14. Well head completion: ☒ Pitless adapter <u>12</u> inches above grade		
				15. Well grouted? <u>Yes</u> With: ☒ Neat cement ☒ Bentonite ☐ Concrete Depth: From <u>3</u> ft. to <u>13</u> ft.		
				16. Nearest source of possible contamination: <u>15</u> Direction <u>SE</u> Type <u>Sediment</u> Well disinfected upon completion? ☒ Yes ☐ No		
				17. Pump: Manufacturer's name <u>Pumpco</u> Model number <u>15525</u> HP <u>1/2</u> Volts <u>220</u> Length of drop pipe <u>40</u> ft. capacity <u>15</u> g.p.m. Type: ☒ Submersible ☐ Turbine ☐ Jet ☐ Reciprocating ☐ Centrifugal ☐ Other		
18. Elevation:		19. Remarks: <u>Customer to pour his own 4x4x4 slab at grade according to state regulations</u>		20. Water well contractor's certification: This well was drilled under my jurisdiction and this report is true to the best of my knowledge and belief. <u>Wmenger Bullen</u> 318 Business name <u>Edwigh KS</u> License No. Address <u>Edwigh KS</u> Signed <u>Wmenger Bullen</u> Date <u>2/3/76</u> Authorized representative		

Forward the white, blue and pink copies to the Department of Health and Environment

Form WWC-3