

1	LOCATION OF WATER WELL:	Fraction	Section Number	Township Number	Range Number
County:	<i>Saline</i>	<i>SE 1/4 SW 1/4 NE 1/4</i>	<i>9</i>	<i>T 27 S</i>	<i>R 1 E/W</i>

Distance and direction from nearest town or city street address of well if located within city?


1805 North West Parkway

2. WATER WELL OWNER: *Mr. Cook*
RR#, St. Address, Box # : *1805 North West Parkway*
City, State, ZIP Code : *Wichita Kansas 67212*

Board of Agriculture, Division of Water Resources
Application Number: *none*

3 LOCATE WELL'S LOCATION WITH AN "X" IN SECTION BOX:

4 DEPTH OF COMPLETED WELL.....44 ft. ELEVATION:1300

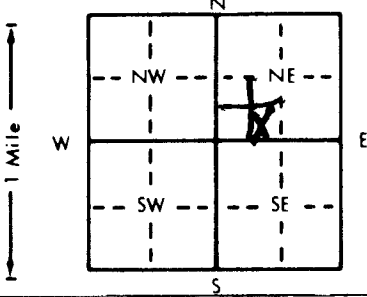

Depth(s) Groundwater Encountered 1. 24 ft. 2. _____ ft. 3. _____ ft.

WELL'S STATIC WATER LEVEL 24 ft. below land surface measured on mo/day/yr 5-13-94

Pump test data: Well water was _____ ft. after _____ hours pumping _____ gpm

Est. Yield _____ gpm: Well water was _____ ft. after _____ hours pumping _____ gpm

Bore Hole Diameter 9 in. to 20 ft., and _____ in. to _____ ft.

WELL WATER TO BE USED AS:

1 Domestic	3 Feedlot	6 Oil field water supply	9 Dewatering	11 Injection well
2 Irrigation	4 Industrial	<u>7</u> Lawn and garden only	10 Monitoring well	12 Other (Specify below)

Was a chemical/bacteriological sample submitted to Department? Yes _____ No X _____; If yes, mo/day/yr sample was submitted _____

Water Well Disinfected? Yes _____ No X _____

5 TYPE OF BLANK CASING USED: 5 Wrought iron 8 Concrete tile CASING JOINTS: Glued ☒ Clamped ☐
1 Steel 3 RMP (SR) 6 Asbestos-Cement 9 Other (specify below) Welded ☐
(2) PVC 4 ABS 7 Fiberglass Threaded ☐
Blank casing diameter 5 in. to 34 ft. Dia. in. to ft. Dia. in. to ft.
Casing height above land surface 12 in. weight lbs./ft. Wall thickness or gauge No. 160

TYPE OF SCREEN OR PERFORATION MATERIAL:			7 PVC	10 Asbestos-cement
1 Steel	3 Stainless steel	5 Fiberglass	8 RMP (SR)	11 Other (specify)
2 Brass	4 Galvanized steel	6 Concrete tile	9 ABS	12 None used (open hole)

SCREEN OR PERFORATION OPENINGS ARE:

1 Continuous slot	3 Mill slot	5 Gauzed wrapped	8 Saw cut	11 None (open hole)
2 Louvered shutter	4 Key punched	6 Wire wrapped	9 Drilled holes	
		7 Torch cut	10 Other (specify)	

SCREEN-PERFORATED INTERVALS:	From	37	ft. to	77	ft. From		ft. to		ft.
	From		ft. to		ft. From		ft. to		ft.
GRAVEL PACK INTERVALS:	From		ft. to		ft. From		ft. to		ft.
None	From		ft. to		ft. From		ft. to		ft.

6 GROUT MATERIAL: 1 Neat cement 2 Cement grout 3 Bentonite 4 Other
Grout intervals: From 0 ft. to 20 ft., From ft. to ft., From ft. to ft.

What is the nearest source of possible contamination:

1 Septic tank	4 Lateral lines	7 Pit privy	10 Livestock pens	14 Abandoned water well
2 Sewer lines	5 Cess pool	8 Sewage lagoon	11 Fuel storage	15 Oil well/Gas well
3 Watertight sewer lines	6 Seepage pit	9 Feedyard	12 Fertilizer storage	16 Other (specify below)
13 Insecticide storage				

Direction from well? West

How many feet? 11

[illegible]

7 CONTRACTOR'S OR LANDOWNER'S CERTIFICATION: This water well was (1) constructed, (2) reconstructed, or (3) plugged under my jurisdiction and was completed on (mo/day/year) 5-13-94 and this record is true to the best of my knowledge and belief. Kansas Water Well Contractor's License No. 472 This Water Well Record was completed on (mo/day/yr) 5-13-94 under the business name of Bearden Pumps & Well Serv by (signature) David R Beek