


1 LOCATION OF WATER WELL: Fraction NW 1/4 NE 1/4 NW 1/4 Section Number 10 Township Number T 27 S Range Number R 1 EW

Distance and direction from nearest town or city street address of well if located within city? 5555 Zoo Blvd, West side Horseshoe Lake

2 WATER WELL OWNER: Sedgwick County RR#, St. Address, Box #: 5555 Zoo Blvd City, State, ZIP Code: Wichita KS 67212 Board of Agriculture, Division of Water Resources Application Number:

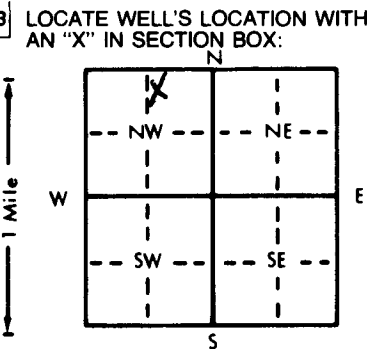

4 DEPTH OF COMPLETED WELL: 20 ft. ELEVATION: 5.0 ft. Depth(s) Groundwater Encountered: 1. 4.83 ft. 2. 5.0 ft. 3. WELL'S STATIC WATER LEVEL: 4.83 ft. below land surface measured on mo/day/yr 8-3-93 Pump test data: Well water was ft. after hours pumping gpm Est. Yield gpm Well water was ft. after hours pumping gpm Bore Hole Diameter: 8 in. to ft. and in. to ft. WELL WATER TO BE USED AS: 5 Public water supply 8 Air conditioning 11 Injection well 1 Domestic 3 Feedlot 6 Oil field water supply 9 Dewatering 12 Other (Specify below) 2 Irrigation 4 Industrial 7 Lawn and garden only 10 Monitoring well Was a chemical/bacteriological sample submitted to Department? Yes No X If yes, mo/day/yr sample was submitted Water Well Disinfected? Yes No X

5 TYPE OF BLANK CASING USED: 1 Steel 3 RMP (SR) 5 Wrought iron 8 Concrete tile CASING JOINTS: Glued Clamped 2 PVC 4 ABS 6 Asbestos-Cement 9 Other (specify below) Welded Threaded Flush Blank casing diameter 2 in. to ft. Dia. in. to ft. Dia. in. to ft. Casing height above land surface: 3 ft. in. weight 703 lbs./ft. Wall thickness or gauge No. 154 TYPE OF SCREEN OR PERFORATION MATERIAL: 1 Steel 3 Stainless steel 5 Fiberglass 8 RMP (SR) 10 Asbestos-cement 2 Brass 4 Galvanized steel 6 Concrete tile 9 ABS 11 Other (specify) 12 None used (open hole) SCREEN OR PERFORATION OPENINGS ARE: 1 Continuous slot 3 Mill slot 5 Gauzed wrapped 8 Saw cut 11 None (open hole) 2 Louvered shutter 4 Key punched 6 Wire wrapped 9 Drilled holes 10 Other (specify) SCREEN-PERFORATED INTERVALS: From 5 ft. to 20 ft. From ft. to ft. GRAVEL PACK INTERVALS: From 4 ft. to 20 ft. From ft. to ft.

6 GROUT MATERIAL: 1 Neat cement 2 Cement grout 3 Bentonite 4 Other Grout intervals: From 4 ft. to 0 ft. From ft. to ft. From ft. to ft. What is the nearest source of possible contamination: 1 Septic tank 4 Lateral lines 7 Pit privy 10 Livestock pens 14 Abandoned water well 2 Sewer lines 5 Cess pool 8 Sewage lagoon 11 Fuel storage 15 Oil well/Gas well 3 Watertight sewer lines 6 Seepage pit 9 Feedyard 12 Fertilizer storage 16 Other (specify below) 13 Insecticide storage NA Direction from well? NA How many feet? NA

FROM TO		LITHOLOGIC LOG	FROM TO	PLUGGING INTERVALS
0.0	1.5	Top Soil, brown, silty, clayey		
1.5	4.5	Sand, rust, fine to med grained		
4.5	8.5	Sand, light brown, fine to med grained		
8.5	13.5	Sand, brown, coarse to very coarse		
13.5	18.5	Sand, gray, med to coarse		
18.5	20.0	Sand, yellow, very fine grained silty, clayey		

The County is asking that this be changed to a flush mount. Waiver Request Sent 8-10-93.

7 CONTRACTOR'S OR LANDOWNER'S CERTIFICATION: This water well was (1) constructed, (2) reconstructed, or (3) plugged under my jurisdiction and was completed on (mo/day/year) 8-3-93 / 8-20-93 and this record is true to the best of my knowledge and belief. Kansas Water Well Contractor's License No. 53 This Water Well Record was completed on (mo/day/yr) 8-10-93 under the business name of GSI by (signature) Allison Truitt