USE TYPEWRITER OR BALL POINT PEN-PRESS FIRMLY, PRINT CLEARLY.

WATER WELL RECORD
KSA 82a-1201-1215

Kansas Department of Health and Environment-Division of Environment
(Water well Contractors)
Topeka, Kansas 66620

1. Location of well:	County	Fraction	Section number	Township number	Range number
	Sedgwick	1/4 SW 1/4 SW 1/4	10	T 27 S	R 1 E/W

2. Distance and direction from nearest town or city: #1 one block north of 13th
Street address of well location if in city: 1/8" east of Ridge

3. Owner of well: West Urban Little League Inc.
R.R. or street: 10008 West Ninth
City, state, zip code: Wichita, Kansas

4. Locate with "X" in section below: Road. Sketch map: Wichita, Kansas

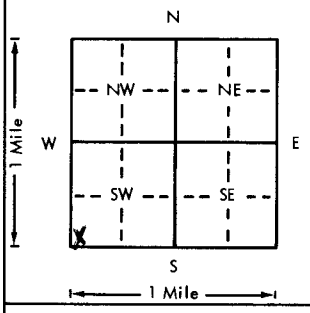

6. Bore hole dia. 11 in. Completion date 7-27-76
Well depth 55 ft.

7. X Cable tool ___ Rotary ___ Driven ___ Dug
___ Hollow rod ___ Jetted ___ Bored ___ Reverse rotary

8. Use: ___ Domestic ___ Public supply ___ Industry
X Irrigation ___ Air conditioning ___ Stock
X Lawn ___ Oil field water ___ Other

9. Casing: Material styrene Height: Above or below ///
Threaded ___ Welded gl Surface 12 in.
RMP X PVC ___ Weight ___ lbs./ft.
Dia. 5 in. to 55 ft. depth Wall Thickness: inches or
Dia. ___ in. to ___ ft. depth gage No. .200

5. Type and color of material	From	To
Sandy Soil	0	3
Medium Sand	3	14
Clay	14	15
Medium Sand	15	52
Shale	52	55
(Use a second sheet if needed)		

10. Screen: Manufacturer's name Sunflower Plastic
Type styrene Dia. 5"
Slot/gauze .06 Length 20'
Set between 35 ft. and 55 ft.
___ ft. and ___ ft.
Gravel pack? yes Size range of material 1/4-1/8"

11. Static water level: mo./day/yr.
20' ft. below land surface Date 7-27-76

12. Pumping level below land surfaces:
___ ft. after ___ hrs. pumping ___ g.p.m.
___ ft. after ___ hrs. pumping ___ g.p.m.
Estimated maximum yield ___ g.p.m.

13. Water sample submitted: mo./day/yr.
___ Yes ___ No Date ___

14. Well head completion: capped
___ Pitless adapter 12 Inches above grade

15. Well grouted? yes
With: ___ Neat cement ___ Bentonite X Concrete
Depth: From 40" ft. to 14 ft.

16. Nearest source of possible contamination: Septic
ft. 300 Direction South Type Tank
Well disinfected upon completion? X Yes ___ No

17. Pump: X Not installed
Manufacturer's name ___
Model number ___ HP ___ Volts ___
Length of drop pipe ___ ft. capacity ___ g.p.m.
Type:
___ Submersible ___ Turbine
___ Jet ___ Reciprocating
___ Centrifugal ___ Other

18. Elevation:
Topography:
___ Hill
___ Slope
___ Upland
___ Valley

19. Remarks: Flat Ground
Water to be used for watering base-ball field.

20. Water well contractor's certification:
This well was drilled under my jurisdiction and this report is true to the best of my knowledge and belief.
Harp Well & Pump 236
Business name License No.
Address Wichita, Kansas
Signed Mary Arnold Date 8-9-76
Authorized representative

27 - 1 - 10 Sw sw
T R (E/W) Sec 1/4 1/4 1/4

Forward the white, blue and pink copies to the Department of Health and Environment

Form WWC-5

MI-1023