


1 LOCATION OF WATER WELL: County: Sedgwick Fraction: NW 1/4 NE 1/4 SE 1/4 Section Number: 11 Township Number: T 27 S Range Number: R 1 E (W)

Distance and direction from nearest town or city street address of well if located within city?

1714 Lynnhurst

2 WATER WELL OWNER: Albert RUPF
RR#, St. Address, Box #: 1619 Coolidge
City, State, ZIP Code: WICHITA, KS 67203
Board of Agriculture, Division of Water Resources
Application Number:

3 LOCATE WELL'S LOCATION WITH AN "X" IN SECTION BOX:

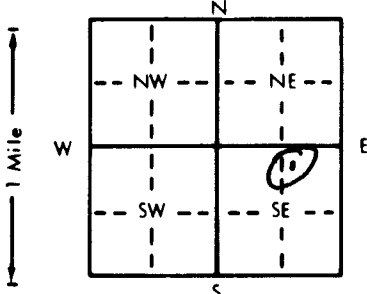

4 DEPTH OF COMPLETED WELL: 35 ft. ELEVATION: 15 ft. below land surface measured on mo/day/yr 5-27-93

Depth(s) Groundwater Encountered 1. N/A ft. 2. N/A ft. 3. N/A ft.

WELL'S STATIC WATER LEVEL 15 ft. below land surface measured on mo/day/yr 5-27-93

Pump test data: Well water was N/A ft. after N/A hours pumping N/A gpm
Est. Yield 8 gpm Well water was N/A ft. after N/A hours pumping N/A gpm
Bore Hole Diameter 8 in. to 15 in. and N/A in. to N/A in.

WELL WATER TO BE USED AS: 5 Public water supply 8 Air conditioning 11 Injection well
1 Domestic 3 Feedlot 6 Oil field water supply 9 Dewatering 12 Other (Specify below)
2 Irrigation 4 Industrial 7 Lawn and garden only 10 Monitoring well

Was a chemical/bacteriological sample submitted to Department? Yes X No X; If yes, mo/day/yr sample was submitted

Water Well Disinfected? Yes X No X

5 TYPE OF BLANK CASING USED: 1 Steel 3 RMP (SR) 5 Wrought iron 8 Concrete tile CASING JOINTS: Glued X Clamped X
2 PVC 4 ABS 6 Asbestos-Cement 9 Other (specify below) Welded N/A
Blank casing diameter 5 in. to 12 in. Dia. 25 ft. Dia. 200 lbs./ft. Wall thickness or gauge No. 1/4 in. to N/A in.

Casing height above land surface 12 in., weight 200 lbs./ft. Dia. 25 ft. Dia. 200 lbs./ft. Wall thickness or gauge No. 1/4 in. to N/A in.

TYPE OF SCREEN OR PERFORATION MATERIAL: 1 Steel 3 Stainless steel 5 Fiberglass 7 PVC 10 Asbestos-cement
2 Brass 4 Galvanized steel 6 Concrete tile 8 RMP (SR) 11 Other (specify)
SCREEN OR PERFORATION OPENINGS ARE: 5 Gauzed wrapped 8 Saw cut 11 None (open hole)
1 Continuous slot 3 Mill slot 6 Wire wrapped 9 Drilled holes
2 Louvered shutter 4 Key punched 7 Torch cut 10 Other (specify)

SCREEN-PERFORATED INTERVALS: From 25 ft. to 35 ft. From N/A ft. to N/A ft. From N/A ft. to N/A ft.

GRAVEL PACK INTERVALS: From N/A ft. to N/A ft. From N/A ft. to N/A ft. From N/A ft. to N/A ft.

6 GROUT MATERIAL: 1 Neat cement 2 Cement grout 3 Bentonite 4 Other

Grout Intervals: From 3 ft. to 13 ft. From N/A ft. to N/A ft. From N/A ft. to N/A ft.

What is the nearest source of possible contamination: 10 Livestock pens 14 Abandoned water well
1 Septic tank 4 Lateral lines 7 Pit privy 11 Fuel storage 15 Oil well/Gas well
2 Sewer lines 5 Cess pool 8 Sewage lagoon 12 Fertilizer storage 16 Other (specify below)
3 Watertight sewer lines 6 Seepage pit 9 Feedyard 13 Insecticide storage

Direction from well? NORTH How many feet? 25

FROM TO LITHOLOGIC LOG FROM TO PLUGGING INTERVALS

0 8 TOP SOIL 0 8
8 22 BRN 1 WH SAND 8 22
22 35 BRN 1 WH PEA SIZE GRAVEL 22 35

7 CONTRACTOR'S OR LANDOWNER'S CERTIFICATION: This water well was (1) constructed, (2) reconstructed, or (3) plugged under my jurisdiction and was completed on (mo/day/year) 5-27-93 and this record is true to the best of my knowledge and belief. Kansas Water Well Contractor's License No. 313 This Water Well Record was completed on (mo/day/yr) 6-2-93 under the business name of JET DRILLING by (signature) [Signature]