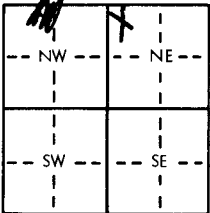
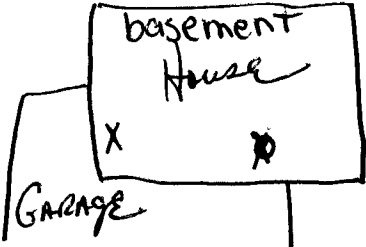


USE TYPEWRITER OR BALL
POINT PEN-PRESS FIRMLY,
PRINT CLEARLY.

WATER WELL RECORD
KSA 82a-1201-1215

Kansas Department of Health and
Environment-Division of Environment
(Water well Contractors)
Topeka, Kansas 66620

SE NE NW NE

1. Location of well:	County <u>Sedgwick</u>	Fraction <u>1/4</u>	Section number <u>12</u>	Township number <u>T 27</u>	Range number <u>R 1W</u>	E/W
2. Distance and direction from nearest town or city: Street address of well location if in city: <u>2817 Cornelison</u>			3. Owner of well: <u>ALBERT WAIT</u> R.R. or street: <u>2817 CORNELISON</u> City, state, zip code: <u>WICHITA, KS. 67203</u>			
4. Locate with "X" in section below: 		Sketch map: 		6. Bore hole dia. <u>11</u> in. Completion date <u>8-17-79</u> Well depth <u>23</u> ft.		
5. Type and color of material		From To		7. ☐ Cable tool ☐ Rotary ☐ Driven ☐ Dug ☐ Hollow rod ☐ Jetted ☒ Bored ☐ Reverse rotary		
				8. Use: ☐ Domestic ☐ Public supply ☐ Industry ☐ Irrigation ☐ Air conditioning ☐ Stock ☒ Lawn ☐ Oil field water ☐ Other		
				9. Casing: Material <u>PVC</u> Height: Above or below Threaded ☐ Welded ☐ Surface <u>12</u> in. RMP ☐ PVC ☒ Weight <u>2.750</u> lbs./ft. Dia. <u>5</u> in. to <u>23</u> ft. depth Wall Thickness: inches or Dia. <u>5</u> in. to <u>23</u> ft. depth Gage No. <u>506-250</u>		
				10. Screen: Manufacturer's name <u>Modern Pipe Co.</u> Type <u>PVC</u> Dia. <u>5.563</u> Slot/gauze <u>.025</u> Length <u>15</u> ☒ between <u>18</u> ft. and <u>23</u> ft. ft. and <u>23</u> ft. Gravel pack? <u>NO</u> Size range of material		
				11. Static water level: <u>20</u> ft. below land surface Date <u>8-17-79</u>		
				12. Pumping level below land surfaces: <u>20</u> ft. after <u>1</u> hrs. pumping <u>15</u> g.p.m. ft. after <u> </u> hrs. pumping <u> </u> g.p.m. Estimated maximum yield <u>50</u> g.p.m.		
				13. Water sample submitted: <u> </u> mo./day/yr. ☐ Yes ☒ No Date <u> </u>		
				14. Well head completion: ☐ Pitless adapter <u>12</u> inches above grade		
				15. Well grouted? <u>YES</u> With: <u>Neat cement</u> Bentonite ☐ Concrete ☐ Depth: From <u>0</u> ft. to <u>10</u> ft.		
				16. Nearest source of possible contamination: ft. <u>20</u> Direction <u>S</u> Type <u>SEWER</u> Well disinfected upon completion? ☒ Yes ☐ No		
				17. Pump: <u>Not installed</u> Manufacturer's name <u>Dempster</u> Model number <u>#F37562</u> HP <u>3/4</u> Volt <u>230</u> Length of drop pipe <u> </u> ft. capacity <u> </u> g.p.m. Type: ☒ Submersible ☐ Turbine ☐ Jet ☐ Reciprocating ☐ Centrifugal ☐ Other		
18. Elevation:		19. Remarks: <u>Well is in finished basement.</u>		20. Water well contractor's certification: This well was drilled under my jurisdiction and this report is true to the best of my knowledge and belief. <u>21st Electric</u> <u>129</u> Business name <u>512 W. 21 / Wichita, KS.</u> License No. Address <u>J. Harris</u> <u>7-15-79</u> Signed <u> </u> Date <u> </u> Authorized representative		

Forward the white, blue and pink copies to the Department of Health and Environment

Form WWC-5