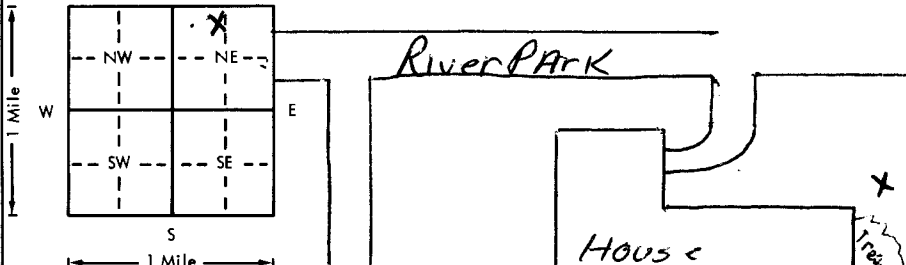


USE TYPEWRITER OR BALL
POINT PEN-PRESS FIRMLY,
PRINT CLEARLY.

WATER WELL RECORD
KSA 82a-1201-1215

Kansas Department of Health and
Environment-Division of Environment
(Water well Contractors)
Topeka, Kansas 66620

1. Location of well:	County <u>Sedgewick</u> <u>SE</u>	Fraction <u>NE 1/4 NW 1/4 NE 1/4</u>	Section number <u>12</u>	Township number <u>T 27</u> <u>S</u>	Range number <u>R 1 W</u> <u>E/W</u>
2. Distance and direction from nearest town or city: Street address of well location if in city: <u>2818 River Park</u>			3. Owner of well: <u>Don Moore</u> R.R. or street: <u>2818 River Park</u> City, state, zip code: <u>Wichita, KS,</u>		
4. Locate with "X" in section below: N W E S 1 Mile 1 Mile			Sketch map: 		
5. Type and color of material			6. Bore hole dia. <u>11</u> in. Completion date <u>11-8-77</u> Well depth <u>40</u> ft.		
			7. ☐ Cable tool ☒ Rotary ☐ Driven ☐ Dug ☐ Hollow rod ☐ Jetted ☐ Bored ☐ Reverse rotary		
			8. Use: ☐ Domestic ☐ Public supply ☐ Industry ☒ Irrigation ☐ Air conditioning ☐ Stock ☒ Lawn ☐ Oil field water ☐ Other		
			9. Casing: Material <u>Steel</u> Height: Above or below Threaded ☐ Welded ☐ Surface <u>12</u> in. RMP ☐ PVC ☒ Weight <u>22.8</u> lbs./ft. Dia. <u>5</u> in. to <u>40</u> ft. depth Wall Thickness: inches or Dia. <u>5</u> in. to <u>40</u> ft. depth gage No. <u>200</u>		
			10. Screen: Manufacturer's name <u>J & L</u> Type <u>100</u> Dia. <u>5"</u> Slot/gauze <u>.065</u> Length <u>10'</u> Set between <u>30</u> ft. and <u>40</u> ft. Gravel pack? ☒ Size range of material <u>3/16 PG gravel</u>		
			11. Static water level: <u>15</u> ft. below land surface Date <u>11-8-77</u> mo./day/yr.		
			12. Pumping level below land surfaces: <u>15</u> ft. after <u>1</u> hrs. pumping <u>15</u> g.p.m. ft. after <u> </u> hrs. pumping <u> </u> g.p.m. Estimated maximum yield <u>50</u> g.p.m.		
			13. Water sample submitted: <u> </u> mo./day/yr. <u> </u> Yes ☒ No Date <u>11-4-77</u>		
			14. Well head completion: <u> </u> Pitless adapter <u>412</u> inches above grade		
			15. Well grouted? <u>yes</u> With: <u> </u> Neat cement <u> </u> Bentonite ☒ Concrete Depth: From <u>0</u> ft. to <u>10</u> ft.		
			16. Nearest source of possible contamination: ft. <u>100</u> Direction <u>SW</u> Type <u>sewage</u> Well disinfected upon completion? ☒ Yes ☐ No		
			17. Pump: <u> </u> Not installed Manufacturer's name <u>Remaster</u> Model number <u> </u> HP <u>1</u> Volts <u>230</u> Length of drop pipe <u>30</u> ft. capacity <u>15</u> g.p.m. Type: ☒ Submersible ☐ Turbine ☐ Jet ☐ Reciprocating ☐ Centrifugal ☐ Other		
			(Use a second sheet if needed)		
18. Elevation: Topography: ☐ Hill ☐ Slope ☐ Upland ☒ Valley		19. Remarks:		20. Water well contractor's certification: This well was drilled under my jurisdiction and this report is true to the best of my knowledge and belief. <u>2157 Electric Co.</u> <u>129</u> Business name <u>512 W. 21st</u> License No. Address <u> </u> Signed <u>J. Harris</u> Date <u>12-5-77</u> Authorized representative	

Forward the white, blue and pink copies to the Department of Health and Environment

Form WWC-5

27 1-10 12 NE 1/4 NE 1/4 NE 1/4