USE TYPEWRITER OR BALL POINT PEN-PRESS FIRMLY, PRINT CLEARLY.

WATER WELL RECORD
KSA 82a-1201-1215

Kansas Department of Health and Environment-Divisian af Environment
(Water well Cantractars)
Topeka, Kansas 66620

1. Location of well:	County: Sedgwick	Fraction: ~~SE~~ NE 1/4 NW 1/4 NE 1/4	Section number: 12	Tawnship number: T 27 S	Range number: R 1 W E (W)

2. Distance and direction from nearest town or city:

Street address of well location if in city:

3. Owner of well: Dr. C.C. Schopf
R.R. or street: 2902 RiverPark Dr.
City, state, zip code: Wichita KS 67203

4. Locate with "X" in section below:

Sketch map:

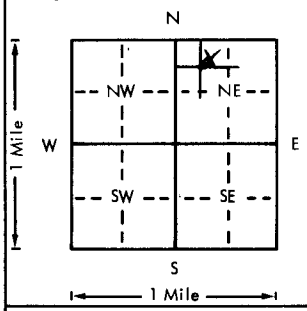

6. Bore hole dia. 9 in. Completian date
Well depth 41 ft. 7-3-80

7. __ Cable tool __ Rotary __ Driven __ Dug
__ Hollow rod __ Jetted X Bored __ Reverse rotary

8. Use: __ Domestic __ Public supply __ Industry
__ Irrigatian __ Air conditioning __ Stock
X Lawn __ Oil field water __ Other

9. Casing: Materiol RMP Height: (Above) or below
Threaded ___ Welded Gld Surface 12 in.
RMP X PVC ___ Weight ___ lbs./ft.
Dia. 6 in. to 0 ft. depth Wall Thickness: inches or
Dia. 6 in. to 41 ft. depth gage No. 120

5. Type and color of material	From	To
DrK. Brn. Clay	0	3
LT Tan fine Sand	3	14
Gray Clay	14	16
LT Tan fine Sand	16	17
Reddish med fine Sand	17	24
LT Brn fine Sand	24	33
LT Brn med Course gravel	33	41
(Use a second sheet if needed)		

10. Screen: Manufacturer's name
Sur-Mac
Type RMP Dia. 6
(Slot)/gauze 3/16 Length 5 ft.
Set between 36 ft. and 41 ft.
___ ft. and ___ ft.
Gravel pack? No Size range of material ___

11. Static water level: mo./day/yr.
20 ft. below land surface Date 7-3-80

12. Pumping level below land surfaces:
1 ft. after 1 hrs. pumping 25 g.p.m.
___ ft. after ___ hrs. pumping ___ g.p.m.
Estimated maximum yield 40 g.p.m.

13. Water sample submitted: mo./day/yr.
__ Yes X No Date ___

14. Well head completion:
__ Pitless adapter 12 Inches above grade

15. Well grouted? Yes
With: __ Neat cement __ Bentonite X Concrete
Depth: From 0 ft. to 11 ft.

16. Nearest source of possible contamination: City
ft. 25 Direction NW Type Sewer
Well disinfected upon completion? ___ Yes X No

17. Pump: Not installed
Manufacturer's name F&W
Model number 10BR9 HP 1 Volts 230
Length of drop pipe 35 ft. capacity 19 g.p.m.
Type:
X Submersible __ Turbine
__ Jet __ Reciprocating
__ Centrifugal __ Other

18. Elevation:

Topography:
__ Hill
__ Slope
__ Upland
X Valley

19. Remarks:

20. Water well contractor's certification:
This well was drilled under my jurisdiction and this report is true to the best of my knowledge and belief.
Protherae Pump & Well 295
Business name License No.
Address 827 W. 27th So Wichita KS
Signed [signature] Date 7-7-80
Authorized representative

27 T — 1 R (W) m — 12 Sec — NE 1/4 1/4 1/4 1/4

Forward the white, blue and pink copies to the Department of Health and Environment

Form WWC-5

MI-1023