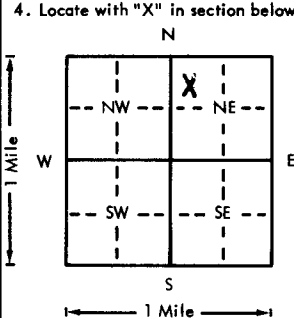


USE TYPEWRITER OR BALL
POINT PEN—PRESS FIRMLY,
PRINT CLEARLY.

WATER WELL RECORD
KSA 82a-1201-1215

Kansas Department of Health and
Environment—Division of Environment
(Water well Contractors)
Topeka, Kansas 66620

1. Location of well:		County <u>Sedgwick</u>	Fraction <u>NW NW 1/4 NE 1/4</u>	Section number <u>12</u>	Township number <u>T 27 S R 1 E</u>	Range number <u>1</u>
2. Distance and direction from nearest town or city: Street address of well location if in city:		3. Owner of well: K.R. or street:		City, state, zip code:		
4. Locate with "X" in section below: Sketch map: 		<u>Wichita, Kansas</u>		6. Bore hole dia. <u>11</u> in. Completion date Well depth <u>50</u> ft. <u>3-23-76</u>		
5. Type and color of material		From	To	7. ☒ Cable tool ☒ Rotary ☐ Driven ☐ Dug ☐ Hollow rod ☐ Jetted ☐ Bored ☐ Reverse rotary		
<u>Sandy Topsoil</u>		<u>0</u>	<u>3</u>	8. Use: ☐ Domestic ☐ Public supply ☐ Industry ☐ Irrigation ☐ Air conditioning ☐ Stock ☒ Lawn ☐ Oil field water ☐ Other		
<u>Fine Sand</u>		<u>3</u>	<u>15</u>	9. Casing: Material <u>STYRENE</u> Height <u>12</u> in. or below Threading <u>GL</u> Surface <u>12</u> in. RMP ☒ PVC ☐ Weight <u>12</u> lbs./ft. Dia. <u>5</u> in. to <u>50</u> ft. depth Wall Thickness: inches or Dia. <u>5</u> in. to <u>50</u> ft. depth gage No. <u>200</u>		
<u>Coarse Sand</u>		<u>15</u>	<u>25</u>	10. Screen: Manufacturer's name <u>SUN FLOWER PLASTIC</u> Type <u>STYRENE</u> Dia. <u>5</u> in. Slot gauge <u>106</u> Length <u>30</u> Set between <u>30</u> ft. and <u>30</u> ft. Gravel pack? <u>YES</u> Size range of material <u>1/4 - 1/8</u> in.		
<u>Coarse Sand with fine</u>				11. Static water level: <u>17</u> ft. below land surface Date <u>3-23-76</u>		
<u>Gravel</u>		<u>25</u>	<u>50</u>	12. Pumping level below land surfaces: ____ ft. after ____ hrs. pumping ____ g.p.m. ____ ft. after ____ hrs. pumping ____ g.p.m. Estimated maximum yield ____ g.p.m.		
				13. Water sample submitted: ____ mo./day/yr. Yes ____ No ____ Date ____		
				14. Well head completion: ☒ Pitless adapter <u>12</u> inches above grade		
				15. Well grouted? <u>YES</u> With: <u>Neat cement</u> ☐ Bentonite ☒ Concrete Depth: From <u>40</u> ft. to <u>14</u> ft.		
				16. Nearest source of possible contamination: ft. <u>60</u> Direction <u>East</u> Type <u>City Sewer</u> Well disinfected upon completion? ☐ Yes ☐ No		
				17. Pump: Manufacturer's name <u>Ita-Rite</u> Not installed Model number <u>1P602</u> <u>3/4</u> hp Volts <u>230</u> Length of drop pipe <u>30</u> ft. capacity <u>20</u> g.p.m. Type: ☒ Submersible ☐ Turbine ☐ Jet ☐ Reciprocating ☐ Centrifugal ☐ Other		
18. Elevation:		19. Remarks:		20. Water well contractor's certification:		
Topography: ☐ Hill ☐ Slope ☐ Upland ☐ Valley		<u>Flat Ground</u> <u>well to be used for</u> <u>lawn watering only.</u>		This well was drilled under my jurisdiction and this report is true to the best of my knowledge and belief. <u>HARP WELLS & PUMP 236</u> Business name <u>WICHITA, KANSAS</u> License No. ____ Address <u>W. Arnold</u> Date <u>4-30-76</u> Signed <u>W. Arnold</u> Authorized representative		

Forward the white, blue and pink copies to the Department of Health and Environment

Form WWC-5