


1	LOCATION OF WATER WELL: County: <u>Sedgewick</u>	Fraction <u>SW</u> $\frac{1}{4}$ <u>NW</u> $\frac{1}{4}$ <u>NW</u> $\frac{1}{4}$	Section Number <u>12</u>	Township Number T <u>27</u> S	Range Number R <u>1</u> E <u>(W)</u>
---	---	---	-----------------------------	----------------------------------	---

Distance and direction from nearest town or city street address of well if located within city?
2011 North West Street Wichita, KS mw-7

2	WATER WELL OWNER:	Fina Oil and Chemical Company	Board of Agriculture, Division of Water Resources Application Number:
	RR#, St. Address, Box # :	P.O. Box 2156	
	City, State, ZIP Code :	Dallas, TX 75221	

3 LOCATE WELL'S LOCATION WITH AN "X" IN SECTION BOX: 4' DEPTH OF COMPLETED WELL: 27.6 ft. ELEVATION: 19.5

Depth(s) Groundwater Encountered 1. 19.5 ft. 2. ft. 3. ft.

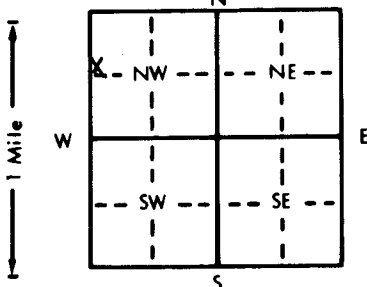

4' DEPTH OF COMPLETED WELL.....27.6 ft. ELEVATION:.....
 Depth(s) Groundwater Encountered 1. 19.5 ft. 2. ft. 3. ft.
 WELL'S STATIC WATER LEVEL ft. below land surface measured on mo/day/yr
 Pump test data: Well water was ft. after hours pumping gpm
 Est. Yield gpm Well water was ft. after hours pumping gpm
 Bore Hole Diameter 7.25 in. to 30 ft., and in. to ft.
 WELL WATER TO BE USED AS: 5 Public water supply 8 Air conditioning 11 Injection well
 1 Domestic 3 Feedlot 6 Oil field water supply 9 Dewatering 12 Other (Specify below)
 2 Irrigation 4 Industrial 7 Lawn and garden only 10 Monitoring well
 Was a chemical/bacteriological sample submitted to Department? Yes.....No. X.....; If yes, mo/day/yr sample was sub-
 mitted Water Well Disinfected? Yes No X

5 TYPE OF BLANK CASING USED: 5 Wrought iron 8 Concrete tile CASING JOINTS: Glued Clamped
1 Steel 3 RMP (SR) 6 Asbestos-Cement 9 Other (specify below) Welded
② PVC 4 ABS 7 Fiberglass Threaded
Blank casing diameter 2 in. to 12.5 ft., Dia in. to ft., Dia in. to ft.
Casing height above land surface 0 in. weight lbs./ft. Wall thickness or gauge No. Sch 40

TYPE OF SCREEN OR PERFORATION MATERIAL:			⑦ PVC	10 Asbestos-cement
1 Steel	3 Stainless steel	5 Fiberglass	8 RMP (SR)	11 Other (specify)
2 Brass	4 Galvanized steel	6 Concrete tile	9 ABS	12 None used (open hole)

SCREEN OR PERFORATION OPENINGS ARE:

1 Continuous slot	3 Mill slot	5 Gauzed wrapped	8 Saw cut	11 None (open hole)
2 Louvered shutter	4 Key punched	6 Wire wrapped	9 Drilled holes	
		7 Torch cut	10 Other (specify)	

SCREEN-PERFORATED INTERVALS:		From . . . 27.6 . . . ft. to . . . 12.5 . . . ft.	From ft. to ft.
		From ft. to ft.	From ft. to ft.
GRAVEL PACK INTERVALS:		From . . . 27.6 . . . ft. to . . . 8 . . . ft.	From ft. to ft.
		From ft. to ft.	From ft. to ft.

6 GROUT MATERIAL: 1 Neat cement 2 Cement grout 3 Bentonite 4 Other
Grout Intervals: 3 From 8 ft. to 6 ft. 2 From 6 ft. to 0 ft. From ft. to ft.

What is the nearest source of possible contamination:

1 Septic tank	4 Lateral lines	7 Pit privy	10 Livestock pens	14 Abandoned water well
2 Sewer lines	5 Cess pool	8 Sewage lagoon	(11) Fuel storage	15 Oil well/Gas well
3 Watertight sewer lines	6 Seepage pit	9 Feedyard	12 Fertilizer storage	16 Other (specify below)
			13 Insecticide storage	

Direction from well? Northwest

How many feet? 130

[illegible]

7 CONTRACTOR'S OR LANDOWNER'S CERTIFICATION: This water well was (1) constructed, (2) reconstructed, or (3) plugged under my jurisdiction and was completed on (mo/day/year) 11/8/91 and this record is true to the best of my knowledge and belief. Kansas Water Well Contractor's License No. 517 This Water Well Record was completed on (mo/day/yr) 11/15/91 under the business name of Groundwater Technology, Inc. by (signature) Dennis White