


1 LOCATION OF WATER WELL: Sedgwick	FRACTION NE 1/4 NE 1/4 SW 1/4	Section Number 12	Township Number T 27 S	Range Number R 1W E/W
--	---	-----------------------------	----------------------------------	---------------------------------

Distance and direction from nearest town or city street address of well if located within city?
1732 Joann Wichita, Kansas

2 WATER WELL OWNER: JONES, Larry RR#, ST. ADDRESS, BOX #: 1732 Joann CITY, STATE, ZIP CODE: Wichita, Kansas	Board of Agriculture, Division of Water Resource Application Number:
---	---

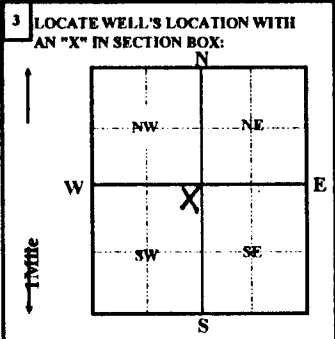

4 DEPTH OF COMPLETED ^{PLUGGED} WELL 26 ft.	ELEVATION:	1 ft.	2 ft.	3 ft.
Depth(s) groundwater Encountered 1 ft.	WELL'S STATIC WATER LEVEL 21 FT. BELOW LAND SURFACE MEASURED ON 04/23/1993	Pump test data: Well water was _____ ft. after _____ hours pumping _____ gpm		
Est. Yield _____ gpm: Well water was _____ ft. after _____ hours pumping _____ gpm	Bore Hole Diameter WAS in. to _____ ft., and _____ in. to _____ ft.	WELL WATER TO BE USED AS: 5 Public water supply 8 Air conditioning 11 Injection well		
1 Domestic 3 Feedlot 6 Oil field water supply 9 Dewatering 12 Other (Specify below)	2 Irrigation 4 Industrial 7 Lawn and garden only 10 Monitoring well	Was a chemical/bacteriological sample submitted to Department? Yes _____ No X ; If yes, mo/day/yr sample was submitted _____		
Water Well Disinfected? Yes X No _____				

5 TYPE OF CASING USED:	5 Wrought iron	8 Concrete tile	CASING JOINTS: Glued Clamped
1 Steel 3 RMP (SR)	6 Asbestos-Cement	9 Other (Specify below)	Welded
2 PVC 4 ABS	7 Fiberglass		Threaded
Blank casing Diameter 6 in. to _____ ft., Dia _____ in. to _____ ft.	Casing height above land surface 72 in., weight _____ lbs. / ft.	Wall thickness or gauge No. _____	
TYPE OF SCREEN OR PERFORATION MATERIAL:			
1 Steel 3 Stainless Steel	5 Fiberglass	8 RMP (SR)	11 other (specify)
2 Brass 4 Galvanized steel	6 Concrete tile	9 ABS	12 None used (open hole)
SCREEN OR PERFORATION OPENING ARE:			
1 Continuous slot 3 Mill slot	5 Gauzed wrapped	8 Saw cut	11 None (open hole)
2 Louvered shutter 4 Key punched	6 Wire wrapped	9 Drilled holes	
7 Torch cut	10 Other (specify)		
SCREEN-PERFORATION INTERVALS: from _____ ft. to _____ ft., From _____ ft. to _____ ft.			
GRAVEL PACK INTERVALS: from _____ ft. to _____ ft., From _____ ft. to _____ ft.			

6 GROUT MATERIAL: 1 Neat cement	2 Cement grout	3 Bentonite	4 Other
Grout Intervals: From 4 ft. to 12 ft., From _____ ft. to _____ ft.			
What is the nearest source of possible contamination:			
1 Septic tank 4 Lateral lines	7 Pit privy	10 Livestock pens	14 Abandon water well
2 Sewer lines 5 Cess pool	8 Sewage lagoon	11 Fuel storage	15 Oil well/Gas well
3 Watertight sewer lines 6 Seepage pit	9 Feedyard	12 Fertilizer storage	16 Other (specify below)
		13 Insecticide storage	
Direction form well? West		How many feet? 6	

FROM	TO	LITHOLOGIC LOG	FROM	TO	PLUGGING INTERVALS
			0	4	clay and silt
			4	12	cement grout
			12	21	bentonite hole plug
			21	26	chlorinated sand and gravel

7 CONTRACTOR'S OR LANDOWNER'S CERTIFICATION: This water well was (1) constructed, (2) reconstructed, or (3) <u>plugged</u> under my jurisdiction and was completed on (mo/day/year) 04/23/1993 and this record is true to the best of my knowledge and belief. Kansas Water Well Contractor's License No. 236 This Water Well Record was completed on (mo/day/yr) 04/24/93	
Under the business name of Harp Well & Pump Service, Inc by (signature) <i>Jane Frederick</i>	