NE SW NE NE

WATER WELL RECORD Form WWC-5 KSA 82a-1212

1 LOCATION OF WATER WELL: County: Sedgwick	Fraction: NW ¼ NE ¼ NE ¼	Section Number: 12	Township Number: T 21 S	Range Number: R 1 E/W

Distance and direction from nearest town or city street address of well if located within city? 2001 n Bullinger

2 WATER WELL OWNER: mrs Hollowell

RR#, St. Address, Box # : 2001 Bullinger

City, State, ZIP Code : Wichita Kansas 67203

Board of Agriculture, Division of Water Resources Application Number: none

3 LOCATE WELL'S LOCATION WITH AN "X" IN SECTION BOX:

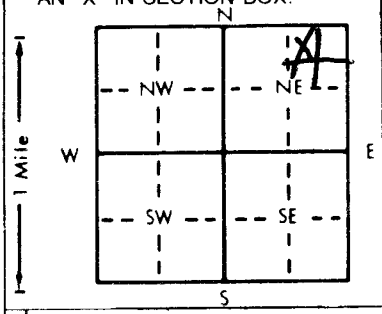

4 DEPTH OF COMPLETED WELL 39 ft. ELEVATION: 1300

Depth(s) Groundwater Encountered 1. 19 ft. 2. ft. 3. ft.

WELL'S STATIC WATER LEVEL 19 ft. below land surface measured on mo/day/yr 3-11-94

Pump test data: Well water was ft. after hours pumping gpm

Est. Yield gpm: Well water was ft. after hours pumping gpm

Bore Hole Diameter 9 in. to 19 ft., and in. to ft.

WELL WATER TO BE USED AS: 5 Public water supply 8 Air conditioning 11 Injection well; 1 Domestic 3 Feedlot 6 Oil field water supply 9 Dewatering 12 Other (Specify below); 2 Irrigation 4 Industrial (7) Lawn and garden only 10 Monitoring well

Was a chemical/bacteriological sample submitted to Department? Yes No X; If yes, mo/day/yr sample was submitted

Water Well Disinfected? Yes No X

5 TYPE OF BLANK CASING USED: 5 Wrought iron 8 Concrete tile; 1 Steel 3 RMP (SR) 6 Asbestos-Cement 9 Other (specify below); (2) PVC 4 ABS 7 Fiberglass

CASING JOINTS: Glued X Clamped; Welded; Threaded

Blank casing diameter 5 in. to 29 ft., Dia in. to ft., Dia in. to ft.

Casing height above land surface 12 in., weight lbs./ft. Wall thickness or gauge No. 160

TYPE OF SCREEN OR PERFORATION MATERIAL: (7) PVC 10 Asbestos-cement; 1 Steel 3 Stainless steel 5 Fiberglass 8 RMP (SR) 11 Other (specify); 2 Brass 4 Galvanized steel 6 Concrete tile 9 ABS 12 None used (open hole)

SCREEN OR PERFORATION OPENINGS ARE: 5 Gauzed wrapped 8 Saw cut 11 None (open hole); 1 Continuous slot (3) Mill slot 6 Wire wrapped 9 Drilled holes; 2 Louvered shutter 4 Key punched 7 Torch cut 10 Other (specify)

SCREEN-PERFORATED INTERVALS: From 29 ft. to 39 ft., From ft. to ft.; From ft. to ft., From ft. to ft.

GRAVEL PACK INTERVALS: From ft. to ft., From ft. to ft.; From ft. to ft., From ft. to ft.

none

6 GROUT MATERIAL: 1 Neat cement (2) Cement grout 3 Bentonite 4 Other

Grout Intervals: From 0 ft. to 19 ft., From ft. to ft., From ft. to ft.

What is the nearest source of possible contamination: 10 Livestock pens 14 Abandoned water well; 1 Septic tank 4 Lateral lines 7 Pit privy 11 Fuel storage 15 Oil well/Gas well; 2 Sewer lines 5 Cess pool 8 Sewage lagoon 12 Fertilizer storage 16 Other (specify below); (3) Watertight sewer lines 6 Seepage pit 9 Feedyard 13 Insecticide storage

Direction from well? South How many feet? 25

FROM	TO	LITHOLOGIC LOG	FROM	TO	PLUGGING INTERVALS
0	6	Top Soil			
6	23	Fine Tan Sand			
23	39	Coarse Tan Sand			

7 CONTRACTOR'S OR LANDOWNER'S CERTIFICATION: This water well was (1) constructed, (2) reconstructed, or (3) plugged under my jurisdiction and was completed on (mo/day/year) 3-11-94 and this record is true to the best of my knowledge and belief. Kansas Water Well Contractor's License No. 472 This Water Well Record was completed on (mo/day/yr) 3-11-94 under the business name of Bearden Pump & Well Ser by (signature) David R Beck

INSTRUCTIONS: Use typewriter or ball point pen. *PLEASE PRESS FIRMLY* and *PRINT* clearly. Please fill in blanks, underline or circle the correct answers. Send top three copies to Kansas Department of Health and Environment, Bureau of Water, Topeka, Kansas 66620-0001. Telephone: 913-296-5545. Send one to WATER WELL OWNER and retain one for your records.

OFFICE USE ONLY T R E/W SEC. ¼ ¼ ¼