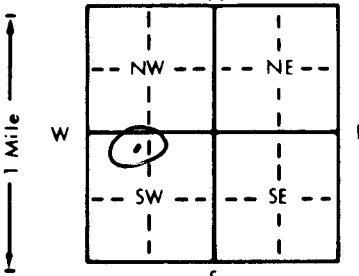


1 LOCATION OF WATER WELL:		Fraction	Section Number	Township Number	Range Number
County: <u>Sedgwick</u>		<u>NE 1/4 NW 1/4 SW 1/4</u>	<u>12</u>	<u>T 27 S</u>	<u>R 1 EW</u>
Distance and direction from nearest town or city street address of well if located within city? <u>1801 Westridge</u>					
2 WATER WELL OWNER: <u>MORT EMMONS</u>					
RR#, St. Address, Box #: <u>1801 WESTRIDGE</u>					
City, State, ZIP Code: <u>WICHITA, KS 67203</u>					
Board of Agriculture, Division of Water Resources					
Application Number:					
3 LOCATE WELL'S LOCATION WITH AN "X" IN SECTION BOX:		4 DEPTH OF COMPLETED WELL: <u>40</u> ft. ELEVATION:			
		Depth(s) Groundwater Encountered 1. <u>N/A</u> ft. 2. ft. 3. ft.			
		WELL'S STATIC WATER LEVEL <u>22</u> ft. below land surface measured on mo/day/yr <u>3-29-94</u>			
		Pump test data: Well water was <u>N/A</u> ft. after hours pumping gpm			
		Est. Yield gpm: Well water was ft. after hours pumping gpm			
		Bore Hole Diameter <u>8</u> in. to <u>22</u> in. to in. to in. to			
		WELL WATER TO BE USED AS: 5 Public water supply 8 Air conditioning 11 Injection well			
		1 Domestic 3 Feedlot 6 Oil field water supply 9 Dewatering 12 Other (Specify below)			
		2 Irrigation 4 Industrial 7 Lawn and garden only 10 Monitoring well			
		Was a chemical/bacteriological sample submitted to Department? Yes No If yes, mo/day/yr sample was submitted			
		Water Well Disinfected? Yes <u>X</u> No			
5 TYPE OF BLANK CASING USED:					
1 Steel 3 RMP (SR) 5 Wrought iron 8 Concrete tile CASING JOINTS: Glued <u>X</u> Clamped					
2 PVC 4 ABS 6 Asbestos-Cement 9 Other (specify below) Welded					
7 Fiberglass Threaded					
Blank casing diameter <u>5</u> in. to <u>30</u> ft. Dia. in. to in. to in. to in. to					
Casing height above land surface <u>12</u> in. weight <u>200</u> lbs./ft. Wall thickness or gauge No. <u>14</u>					
TYPE OF SCREEN OR PERFORATION MATERIAL:					
1 Steel 3 Stainless steel 5 Fiberglass 8 RMP (SR) 10 Asbestos-cement					
2 Brass 4 Galvanized steel 6 Concrete tile 9 ABS 11 Other (specify)					
12 None used (open hole)					
SCREEN OR PERFORATION OPENINGS ARE:					
1 Continuous slot 3 Mill slot 5 Gauzed wrapped 8 Saw cut 11 None (open hole)					
2 Louvered shutter 4 Key punched 6 Wire wrapped 9 Drilled holes					
7 Torch cut 10 Other (specify)					
SCREEN-PERFORATED INTERVALS: From ft. to <u>40</u> ft. From ft. to ft. From ft. to ft. From ft. to ft.					
GRAVEL PACK INTERVALS: From <u>N/A</u> ft. to <u>N/A</u> ft. From ft. to ft. From ft. to ft. From ft. to ft.					
6 GROUT MATERIAL: 1 Neat cement 2 Cement grout 3 Bentonite 4 Other					
Grout Intervals: From <u>0</u> ft. to <u>13</u> ft. From ft. to ft. From ft. to ft. From ft. to ft.					
What is the nearest source of possible contamination:					
1 Septic tank 4 Lateral lines 7 Pit privy 10 Livestock pens 14 Abandoned water well					
2 Sewer lines 5 Cess pool 8 Sewage lagoon 11 Fuel storage 15 Oil well/Gas well					
3 Watertight sewer lines 6 Seepage pit 9 Feedyard 12 Fertilizer storage 16 Other (specify below)					
13 Insecticide storage					
Direction from well? <u>N</u> How many feet? <u>35</u>					
FROM		TO		LITHOLOGIC LOG	
FROM		TO		PLUGGING INTERVALS	
0		8		TOP SOIL	
8		25		BRN & WHT SAND	
25		35		BRN & WHT PEASIZE GRAVEL	
35		40		MED SIZE GRAVEL	
7 CONTRACTOR'S OR LANDOWNER'S CERTIFICATION: This water well was (1) constructed, (2) reconstructed, or (3) plugged under my jurisdiction and was completed on (mo/day/year) <u>3-29-94</u> and this record is true to the best of my knowledge and belief. Kansas Water Well Contractor's License No. <u>313</u> This Water Well Record was completed on (mo/day/yr) <u>6-22-94</u> under the business name of <u>JET DRILLING</u> by signature <u>[Signature]</u>					