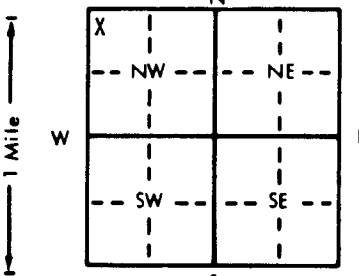


1 LOCATION OF WATER WELL: County: Sedgwick		Fraction NW 1/4 NW 1/4 NW 1/4	Section Number 13	Township Number T 27 S	Range Number R 1 E																														
Distance and direction from nearest town or city street address of well if located within city? 120' South of 3935 West 13th Street, Wichita, KS 50885091 MW-2																																			
2 WATER WELL OWNER: Groundwater Management Section, Amoco Corporation RR#, St. Address, Box # : 4502 E. 41st Street Board of Agriculture, Division of Water Resources City, State, ZIP Code : Tulsa, OK 74135 Application Number:																																			
If yes, mo/day/yr sample was submitted Water Well Disinfected? Yes No X																																	

pit 9 Feedyard 12 Fertilizer storage 16 Other (specify below) 13 Insecticide storage Direction from well? Southwest How many feet? 30																																			
<table border="1"><thead><tr><th>FROM</th><th>TO</th><th>LITHOLOGIC LOG</th><th>FROM</th><th>TO</th><th>PLUGGING INTERVALS</th></tr></thead><tbody><tr><td></td><td>3.5</td><td>Dark Brown Lean Clay</td><td></td><td></td><td></td></tr><tr><td>3.5</td><td>21.5</td><td>Tan to Red-Brown Fine Sand</td><td></td><td></td><td></td></tr><tr><td>21.5</td><td>27.0</td><td>Dark Gray Fat Clay</td><td></td><td></td><td></td></tr><tr><td colspan="6">CASING AND SCREEN WERE REMOVED, BOREHOLE WAS DRILLED TO 20' AND FILLED WITH CEMENT-BENTONITE GROUT ON 07/17/89.</td></tr>
7 CONTRACTOR'S OR LANDOWNER'S CERTIFICATION: This water well was (1) constructed, (2) reconstructed, or 3 plugged under my jurisdiction and was completed on (mo/day/year) 07/17/89 and this record is true to the best of my knowledge and belief. Kansas Water Well Contractor's License No. 416 This Water Well Record was completed on (mo/day/yr) 7-21-89 under the business name of Terracon Consultants, Inc. by (signature) <i>[Signature]</i>																																			
INSTRUCTIONS: Use typewriter or ball point pen. PLEASE PRESS FIRMLY and PRINT clearly. Please fill in blanks, underline or circle the correct answers. Send top three copies to Kansas Department of Health and Environment, Bureau of Water Protection, Topeka, Kansas 66620-7320. Telephone: 913-296-5514. Send one to WATER WELL OWNER and retain one for your records.																																			