

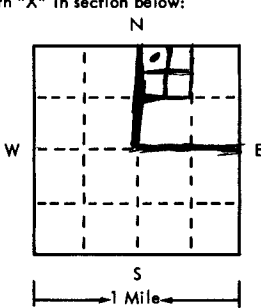
Sent 10/10/75

USE TYPEWRITER OR BALL  
POINT PEN-PRESS FIRMLY,  
PRINT CLEARLY.

WATER WELL RECORD  
KSA 82a-1201-1215

T R EW sec 1/4 1/4 1/4 No.

Kansas State Dept. Of Health  
(Water Well Contractors)  
Forbes-Bldg. 740  
Topeka, Kansas 66620

|   |                           |                                 |   |                             |                            |   |
|---|---------------------------|---------------------------------|---|-----------------------------|----------------------------|---|
| 1 Location of well:   | County<br><u>Sedgwick</u> | Township name<br><u>Wichita</u> | Fraction<br><u>NW 1/4</u><br><u>NW 1/4</u><br><u>NE 1/4</u>   | Section number<br><u>13</u> | Town number<br><u>T27S</u> | Range number<br><u>R1W</u>   |
| Distance and direction from nearest town or city:   |                           |                                 | 3 Owner of well: <u>Max Prier</u>   |                             |                            |   |
| Street address of well location if in city: <u>1221 Mt Carmel Ct</u>   |                           |                                 | Address: <u>1224 N Sheridan</u>   |                             |                            |   |
| Locate with "X" in section below:<br>   |                           |                                 | Sketch map:<br><u>NW 1/4 of the</u><br><u>NW 1/4 of the</u><br><u>NE 1/4</u>   |                             |                            | 4 Well depth: <u>35</u> ft. Date of completion: <u>8-5-75</u><br>Well diameter: <u>2</u> in. <u>Bore</u>   |
| 2   |                           |                                 | Type and color of material   |                             |                            | 5 <input type="checkbox"/> Cable tool <input type="checkbox"/> Rotary <input type="checkbox"/> Driven <input type="checkbox"/> Dug<br><input type="checkbox"/> Hollow rod <input type="checkbox"/> Jetted <input checked="" type="checkbox"/> Bored <input type="checkbox"/> Reverse rotary   |
|   |                           |                                 | From To   |                             |                            | 6 Use: <input checked="" type="checkbox"/> Domestic <input type="checkbox"/> Public supply <input type="checkbox"/> Industry<br><input checked="" type="checkbox"/> Irrigation <input type="checkbox"/> Air conditioning <input type="checkbox"/> Commercial<br><input type="checkbox"/> Test well <input type="checkbox"/>                                                                                    |
| <u>DARK GRAY CLAY</u>   |                           |                                 | <u>0</u> <u>4</u>   |                             |                            | 7 Casing: Material <u>PVC</u> Height: above/below<br>Threaded <input type="checkbox"/> Welded <input type="checkbox"/> Surface <u>12</u> in.<br>Diam. <u>1 1/2</u> in. to <u>0</u> ft. depth Drive shoe? <input type="checkbox"/> Yes <input type="checkbox"/> No<br><u>1 1/2</u> in. to <u>35</u> ft. depth                                                                                                   |
| <u>LT. BROWN med SAND</u>   |                           |                                 | <u>4</u> <u>13</u>   |                             |                            | 8 Screen: <u>Sunflower</u><br>Manufacturer <u>P.V.C.</u> Dia. <u>1 1/2</u> "<br>Type <u>P.V.C.</u> Length <u>5'</u><br>Slot/gauze <u>3/16</u> Set between <u>30</u> ft. and <u>35</u> ft.<br>Fittings:<br>Gravel pack <input type="checkbox"/> Yes <input checked="" type="checkbox"/> No Size range of material                                                                                               |
| <u>LT BROWN med GRAVEL</u>   |                           |                                 | <u>13</u> <u>35</u>   |                             |                            | 9 Static water level:<br><u>13</u> ft. below land surface Date <u>8-5-75</u>   |
|   |                           |                                 |   |                             |                            | 10 Pumping level below land surfaces:<br>____ ft. after ____ hrs. pumping ____ g.p.m.<br>____ ft. after ____ hrs. pumping ____ g.p.m.<br>Estimated maximum yield ____ g.p.m.   |
|   |                           |                                 |   |                             |                            | 11 Water sample submitted:<br><input type="checkbox"/> Yes <input checked="" type="checkbox"/> No Date   |
|   |                           |                                 |   |                             |                            | 12 Well head completion:<br><input type="checkbox"/> Pitless adapter <u>12'</u> <input checked="" type="checkbox"/> Inches above grade   |
|   |                           |                                 |   |                             |                            | 13 Well grouted? <input checked="" type="checkbox"/> Yes <input type="checkbox"/> No<br><input checked="" type="checkbox"/> Neat cement <input type="checkbox"/> Bentonite <input type="checkbox"/><br>Depth: From <u>0</u> ft. to <u>13</u> ft.   |
|   |                           |                                 |   |                             |                            | 14 Nearest source of possible contamination: <u>SUMP</u><br>ft. <u>12</u> Direction <u>West</u> Type <u>PUMP</u><br>Well disinfected upon completion? <input checked="" type="checkbox"/> Yes <input type="checkbox"/> No   |
|   |                           |                                 |   |                             |                            | 15 Pump: <input checked="" type="checkbox"/> Not installed<br>Manufacturer's name<br>Model number ____ HP ____ Volts ____<br>Length of drop pipe ____ ft. capacity ____ g.p.m.<br>Type:<br><input type="checkbox"/> Submersible <input type="checkbox"/> Turbine<br><input type="checkbox"/> Jet <input type="checkbox"/> Reciprocating<br><input type="checkbox"/> Centrifugal <input type="checkbox"/> Other |
| (use a second sheet if needed)   |                           |                                 |   |                             |                            |   |
| 16 Remarks: elevation<br><br>Topography:<br><input type="checkbox"/> Hill<br><input type="checkbox"/> Slope<br><input type="checkbox"/> Upland<br><input checked="" type="checkbox"/> Valley<br><br><u>Grade Basement floor</u> |                           |                                 | 17 Water well contractor's certification:<br>This well was drilled under my jurisdiction and this report is true to the best of my knowledge and belief.<br><u>Protheroe Pump &amp; Well 295</u><br>Business name <u>827 W. 27th St.</u> License No.<br>Address <u>Protheroe</u> Signed <u>8-5-75</u> Date<br>Authorized representative |                             |                            |   |