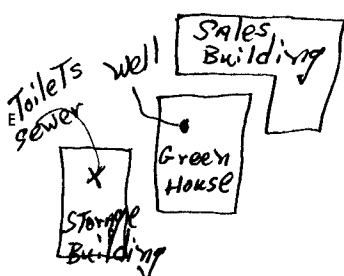


USE TYPEWRITER OR BALL
POINT PEN-PRESS FIRMLY,
PRINT CLEARLY.

WATER WELL RECORD
KSA 82a-1201-1215

Kansas Department of Health and
Environment-Division of Environment
(Water well Contractors)
Topeka, Kansas 66620

1. Location of well:		County Sedgwick	Fraction NE 1/4 NW 1/4 NE 1/4	Section number 13	Township number T 27 S R 1 W E/W	Range number 1 W E/W
2. Distance and direction from nearest town or city: Street address of well location if in city: 2707 W 13th			3. Owner of well: HAROLD Johnson R.R. or street: 2707 W 13 City, state, zip code: Wichita KS 67203			
4. Locote with "X" in section below: N W S E 1 Mile 1 Mile		Sketch map: N 		6. Bore hole dia. 9 in. Completion date 5/12/77 Well depth 35 ft.		
5. Type and color of material		From		To		7. Cable tool ☐ Rotary ☐ Driven ☐ Dug ☐ Hollow rod ☐ Jetted ☒ Bored ☐ Reverse rotary
						8. Use: Domestic ☐ Public supply ☐ Industry ☐ Irrigation ☐ Air conditioning ☐ Stock ☐ ☒ Lawn ☐ Oil field water ☐ Other
						9. Casing: Material PVC Height: Above or below Threaded ☐ Welded ☒ Surface 12 in. RMP ☐ PVC ☒ Weight ☐ lbs./ft. Dia. 5 in. to 0 ft. depth Wall Thickness: inches or Dia. 5 in. to 35 ft. depth page No. 0320 D
						10. Screen: Manufacturer's name Sunflower Type PVC Dia. 5 Slot/gauze 3/16 Length 10 ft Set between 25 ft. and 35 ft. ft. and ft. Gravel pack? No Size range of material
						11. Static water level: mo./day/yr. 19 ft. below land surface Date 5/12/77
						12. Pumping level below land surfaces: ft. after hrs. pumping g.p.m. ft. after hrs. pumping g.p.m. Estimated maximum yield 50 g.p.m.
						13. Water sample submitted: mo./day/yr. Yes ☒ No ☐ Date
						14. Well head completion: Pitless adapter 12 inches above grade
						15. Well grouted? Yes With: Neat cement ☐ Bentonite ☐ ☒ Concrete Depth: From 0 ft. to 11 ft.
						16. Nearest source of possible contamination: ft. 75 Direction SW Type Sewer Well disinfected upon completion? ☒ Yes ☐ No
						17. Pump: ☒ Not installed Manufacturer's name Model number HP Volts Length of drop pipe ft. capacity g.p.m. Type: ☐ Submersible ☐ Turbine ☐ Jet ☐ Reciprocating ☐ Centrifugal ☐ Other
						20. Water well contractor's certification: This well was drilled under my jurisdiction and this report is true to the best of my knowledge and belief. Protheroe Pump Well 295 Business name 827 W 27th So License No. Address 827 W 27th So Signed Protheroe Date 5/12/77 Authorized representative
						18. Elevation:
						19. Remarks: LAWN & Garden
						Topography: ☐ Hill ☐ Slope ☐ Upland ☒ Valley

Forward the white, blue and pink copies to the Department of Health and Environment

Form WWC-5