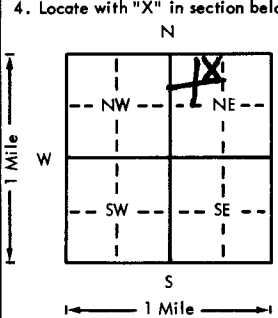


USE TYPEWRITER OR BALL
POINT PEN-PRESS FIRMLY,
PRINT CLEARLY.

WATER WELL RECORD
KSA 82a-1201-1215

Kansas Department of Health and
Environment-Division of Environment
(Water well Contractors)
Topeka, Kansas 66620

1. Location of well:	County	Fraction	Section number	Township number	Range number
	SEDGWICK	NE 1/4 NW 4 NE	14	T 27 S R 1W E/W	
2. Distance and direction from nearest town or city:	3. Owner of well:		FM DEVELOPEMENT		
Street address of well location if in city: 1209 N. CLARA	R.R. or street:		1630 LYNN HURST 67211		
4. Locate with "X" in section below:		Sketch map:		6. Bore hole dia. 8 in. Completion date 9-20-77	
		BORED 8" HOLE TO 10 FT. IN- STALLED 4" CASING. - DROVE PIPE & POINT GROUTED CASING		Well depth 24 ft. BASEMENT	
5. Type and color of material		From	To	7. Cable tool Rotary ☒ Driven ☐ Dug ☐ Hollow rod ☐ Jetted ☒ Bored ☐ Reverse rotary ☐	
SAND MEDIUM TAN		0	2	8. Use: ☒ Domestic ☐ Public supply ☐ Industry ☐ Irrigation ☐ Air conditioning ☐ Stock ☐ Lawn ☐ Oil field water ☐ Other	
SAND COARSE BROWN		2	2.5	9. Casing: Material RMP Height: 12 in. or below Threaded 3/4" Welded ☒ Surface 12 in. RMP ☒ PVC Weight 155 lbs./ft. Dia. 4 in. to 11 ft. depth Wall Thickness: inches or Dia. in. to ft. depth gage No. 200	
SAND GRAY FINE		2.5	4	10. Screen: Manufacturer's name CLAYTON MARK Type BRASS Dia. 1.25" Slot/gauze .060 Length 4 FT. Set between 20 ft. and 4 ft. Gravel pack? ☒ Size range of material	
SAND MEDIUM TAN		4	8	11. Static water level: BASEMENT mo./day/yr. 11 ft. below surface Date 9-20-77	
SAND BROWN COARSE		8	10	12. Pumping level below land surfaces: ft. after hrs. pumping NA g.p.m. ft. after hrs. pumping g.p.m. Estimated maximum yield 35 g.p.m.	
DROVE 1.25 SAND POINT & PIPE TO		10	24	13. Water sample submitted: mo./day/yr. Yes ☒ No ☐ Date	
				14. Well head completion: Pitless adapter 12 BASEMENT Inches above grade	
				15. Well grouted? YES With: ☒ Neat cement ☐ Bentonite ☐ Concrete Depth: From 0 ft. to 10 ft.	
				16. Nearest source of possible contamination: ft. 12 Direction NORTH Type SEWER-PLAS. Well disinfected upon completion? ☒ Yes ☐ No	
				17. Pump: Not installed Manufacturer's name FETCO COALDS Model number 105N HP 050 Volts 115 Length of drop pipe 24 ft. capacity 12 g.p.m. Type: ☒ Submersible ☐ Turbine ☒ Jet ☐ Reciprocating ☐ Centrifugal ☐ Other	
18. Elevation: 1300 FT		19. Remarks:		20. Water well contractor's certification: This well was drilled under my jurisdiction and this report is true to the best of my knowledge and belief. BEARDEN PUMP & WELL INC. Business name License No. Address 3142 MENTON WICHITA KS Signed Otis W. Beard Date 4/14/77 Authorized representative	

Forward the white, blue and pink copies to the Department of Health and Environment

Form WWC-5