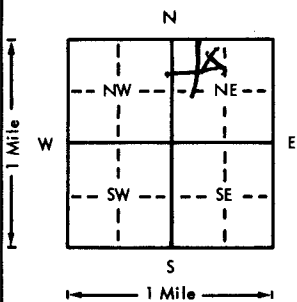


USE TYPEWRITER OR BALL
POINT PEN-PRESS FIRMLY,
PRINT CLEARLY.

WATER WELL RECORD
KSA 82a-1201-1215

Kansas Department of Health and
Environment-Division of Environment
(Water well Contractors)
Topeka, Kansas 66620

1. Location of well:		County SEDGWICK	Fraction NE 1/4 NW 1/4 NE 1/4	Section number 14	Township number T 27 S	Range number R 1W E/W
2. Distance and direction from nearest town or city: Street address of well location if in city: 1232 N CLARA WICHITA KANS				3. Owner of well: F M DEVELOPEMENT R.R. or street: 1630 RYNHURST City, state, zip code: WICHITA KANS 67211		
4. Locate with "X" in section below:		Sketch map:		6. Bore hole dia. 8 in. Completion date 4-2-77 Well depth 24 ft. FROM BASEMENT		
		BORED 8" HOLE TO 10' - INSTALLED 4" CASING - DROVE PIPE & POINT- GROUTED CASING		7. ☐ Cable tool ☐ Rotary ☒ Driven ☐ Dug ☐ Hollow rod ☐ Jetted ☒ Bored ☐ Reverse rotary		
5. Type and color of material				From	To	8. Use: ☒ Domestic ☐ Public supply ☐ Industry ☐ Irrigation ☐ Air conditioning ☐ Stock ☐ Lawn ☐ Oil field water ☐ Other
SAND - BROWN -				0	2	9. Casing: Material RMP Height Above or below BASEMENT FLOOR Threaded 30 in. ☒ Surface 12 in. RMP ☒ PVC Weight 455 lbs./ft.
SAND TAN - MEDIUM				2	6	Dia. 4 in. to 11 ft. depth Wall Thickness: inches or Dia. 4 in. to 11 ft. depth gage No. 1200
SANDY CLAY GRAY				6	7	10. Screen: Manufacturer's name CLAYTON MARIS Type BRASS Dia. 1.25 Slot/gauze 0.60 Length 4 FT. Set between 20 ft. and 24 ft. ft. and ft.
SAND - BROWN MEDIUM				7	10	Gravel pack? NO Size range of material
DROVE 1.25" SAND POINT						11. Static water level: 11 ft. below land surface Date 4-2-77 mo./day/yr.
TO					24	12. Pumping level below land surfaces: ft. after hrs. pumping NA g.p.m. ft. after hrs. pumping g.p.m. Estimated maximum yield 35 g.p.m.
						13. Water sample submitted: mo./day/yr. Yes ☒ No ☐ Date
						14. Well head completion: Pitless adapter 12 inches above grade
						15. Well grouted? YES With: ☒ Neat cement ☐ Bentonite ☐ Concrete Depth: From 0 ft. to 10 ft.
						16. Nearest source of possible contamination: ft. 15 Direction SD Type PLASTIC Well disinfected upon completion? ☒ Yes ☐ No
						17. Pump: Not installed Manufacturer's name F&W Model number SEPT 5 HP 0.50 volts 115 Length of drop pipe 24 ft. capacity 12 g.p.m. Type: ☒ Submersible ☐ Turbine ☒ Jet ☐ Reciprocating ☐ Centrifugal ☐ Other
(Use a second sheet if needed)						
18. Elevation: 1300		19. Remarks:		20. Water well contractor's certification: This well was drilled under my jurisdiction and this report is true to the best of my knowledge and belief. BEARDEN Pump & Well 104 Business name License No. Address 3147 MENTOR WICHITA KANS Signed O. W. Bearden Date 4-26-77 Authorized representative		

Forward the white, blue and pink copies to the Department of Health and Environment

Form WWC-5