USE TYPEWRITER OR BALL POINT PEN-PRESS FIRMLY, PRINT CLEARLY.

WATER WELL RECORD
KSA 82a-1201-1215

Kansas Department of Health and Environment-Division of Environment
(Water well Contractors)
Topeka, Kansas 66620

1. Location of well:	County	Fraction	Section number	Township number	Range number
	SEDGWICK	NE 1/4 NW 1/4 NE 1/4	14	T 27 S	R 1 W E/W

2. Distance and direction from nearest town or city:
Street address of well location if in city: 1210 N CLARA WICHITA KANS

3. Owner of well: SID VOGE
R.R. or street: 2408 W. DOUGLAS
City, state, zip code: WICHITA KS 67213

4. Locate with "X" in section below:

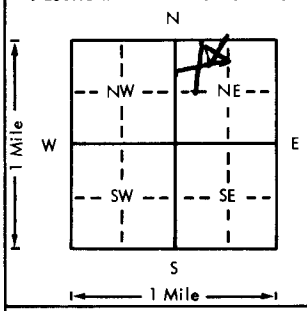

Sketch map: BORED 9" HOLE TO 10' THEN 6" TO 15 FT. USED SAND BUCKET TO COMPLETION AT 34 FT.

6. Bore hole dia. 9 in. Completion date 4/14/78
Well depth 34 ft.

7. __ Cable tool __ Rotary __ Driven __ Dug
__ Hollow rod __ Jetted X Bored __ Reverse rotary

8. Use: X Domestic __ Public supply __ Industry
__ Irrigation __ Air conditioning __ Stock
__ Lawn __ Oil field water __ Other

9. Casing: Material RMP Height: Above or below 9"
Threaded SOL Welded X Surface 9" in.
RMP X PVC ____ Weight 1.55 lbs./ft.
Dia. 5 in. to 34 ft. depth Wall Thickness: inches or
Dia. ____ in. to ____ ft. depth gage No. 0.200

5. Type and color of materiol	From	To
TOP-SOIL SANDY BLACK	0	4
SUB SOIL SANDY TAN	4	6
SAND TAN FINE	6	8
CLAY GRAY	8	9
SAND - YELLOWISH MED.	9	12
SAND MEDIUM TAN	12	15
SAND MEDIUM GRAY	15	23
CLAY BLACK	23	24
SAND COARSE TAN	24	34

(Use a second sheet if needed)

10. Screen: Manufacturer's name SUNFLOWER
Type RMP Dia. 5 INCH
Slot/gauze .031 Length 6.5 FT
Set between 27.5 ft. and 34 ft.
____ ft. and ____ ft.
Gravel pack? NO Size range of material ____

11. Static water level:
15 ft. below land surface Date 4/14/78 mo./day/yr.

12. Pumping level below land surfaces:
____ ft. after ____ hrs. pumping NA g.p.m.
____ ft. after ____ hrs. pumping ____ g.p.m.
Estimated maximum yield 75 g.p.m.

13. Water sample submitted: mo./day/yr.
__ Yes X No Date ____

14. Well head completion:
X Pitless adapter ____ Inches above grade

15. Well grouted? YES
With: X Neat cement ____ Bentonite ____ Concrete
Depth: From 0 ft. to 10 ft.

16. Nearest source of possible contamination:
ft. 12 Direction NW Type PLASTIC SEWER
Well disinfected upon completion? X Yes ____ No

17. Pump: Not installed
Manufacturer's name FFW
Model number 5BA8 HP .50 Volts 220
Length of drop pipe 22 ft. capacity 12 g.p.m.
Type:
✓ Submersible ____ Turbine
____ Jet ____ Reciprocating
____ Centrifugal ____ Other

18. Elevation: 1300 FT.
Topography:
____ Hill
____ Slope
____ Upland
____ Valley

19. Remarks: OWNER WILL BUILD SLAB -

20. Water well contractor's certification:
This well was drilled under my jurisdiction and this report is true to the best of my knowledge and belief.
Business name BEARDEN PUMP & WELL License No. 704
Address 3142 MENTOR WICHITA
Signed Otho W Bearden Date 5/10/78
Authorized representative

27 - 1 W 14 NE NW NE

Forward the white, blue and pink copies to the Department of Health and Environment

Form WWC-5

MI-1023