USE TYPEWRITER OR BALL POINT PEN-PRESS FIRMLY, PRINT CLEARLY.

WATER WELL RECORD
KSA 82a-1201-1215

Kansas Department of Health and Environment-Division of Environment
(Water well Contractors)
Topeka, Kansas 66620

1. Location of well:	County	Fraction	Section number	Township number	Range number
	SEDGWICK	NE 1/4 NW NE	4	T 27 S	R 1W E/W

2. Distance and direction from nearest town or city:
Street address of well location if in city: 1202 W 11TH. WICHITA KANS.

3. Owner of well: RM DEVELOPEMENT
R.R. or street: 1630 LYNNHURST
City, state, zip code: WICHITA KANS 67211

4. Locate with "X" in section below:

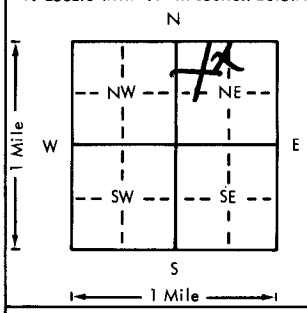

Sketch map: BORED 8" HOLE TO 10 FT. INSTALLED 4" CASING - DROVE PIPE + POINT TO COMPLETION OR UTE CASING.

6. Bore hole dia. 8 in. Completion date 5/16/78
Well depth 24 ft.

7. __ Cable tool __ Rotary X Driven __ Dug
__ Hollow rod __ Jetted X Bored __ Reverse rotary

8. Use: X Domestic __ Public supply __ Industry
__ Irrigation __ Air conditioning __ Stock
__ Lawn __ Oil field water __ Other

9. Casing: Material RMP Height: Above or Below BASEMENT
Threaded OL Welded X Surface M in.
RMP X PVC ___ Weight 1.55 lbs./ft.
Dia. 4 in. to 11 ft. depth Wall Thickness: inches or
Dia. ___ in. to ___ ft. depth gage No. .200

10. Screen: Manufacturer's name CLAYTON MARK
Type BRASS Dia. 1.25 IN.
Slot/gauze .060 Length 4 FT.
Set between 20 ft. and 24 ft.
___ ft. and ___ ft.
Gravel pack? NO Size range of material ___

11. Static water level: 11 ft. below land surface Date 5/16/78 mo./day/yr.

12. Pumping level below land surfaces:
___ ft. after ___ hrs. pumping NA g.p.m.
___ ft. after ___ hrs. pumping ___ g.p.m.
Estimated maximum yield 35 g.p.m.

13. Water sample submitted: mo./day/yr.
___ Yes X No Date ___

14. Well head completion:
___ Pitless adapter 12 inches above grade

15. Well grouted? YES
With: X Neat cement ___ Bentonite ___ Concrete
Depth: From 0 ft. to 10 ft.

16. Nearest source of possible contamination:
ft. 11 Direction WEST Type PLASTIC SEWER
Well disinfected upon completion? X Yes ___ No

17. Pump: Not installed
Manufacturer's name FHW
Model number CB1655 HP .050 Volts 115
Length of drop pipe 24 ft. capacity 12 g.p.m.
Type:
___ Submersible ___ Turbine
X Jet ___ Reciprocating
___ Centrifugal ___ Other

5. Type and color of material

	From	To
SAND- BROWN COARSE	0	2
SAND TAN COARSE	2	5
CLAY GRAY SANDY	5	7
SAND BROWN COARSE	7	10
DROVE 1.25" SAND POINT	10	
+ GALV. PIPE TO		24

(Use a second sheet if needed)

18. Elevation: 1300'
Topography:
___ Hill
___ Slope
___ Upland
X Valley

19. Remarks:

20. Water well contractor's certification:
This well was drilled under my jurisdiction and this report is true to the best of my knowledge and belief.
Business name BEARDEN PUMP & WELL License No. 104
Address 3142 MENTOR WICHITA
Signed Otis W Bearden Date 6/14/78
Authorized representative

S 27 R 1W T 1 Sec 4 1/4 NE NW NE

Forward the white, blue and pink copies to the Department of Health and Environment

Form WWC-5

MI-1023