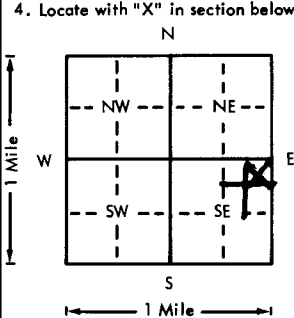


USE TYPEWRITER OR BALL
POINT PEN-PRESS FIRMLY,
PRINT CLEARLY.

WATER WELL RECORD
KSA 82a-1201-1215

Kansas Department of Health and
Environment-Division of Environment
(Water well Contractors)
Topeka, Kansas 66620

1. Location of well:		County	Section number	Township number	Range number
SEDOGWICK		NE 1/4 NE 1/4 SE 1/4	15	T 27 S	R 1W E/W
2. Distance and direction from nearest town or city:		3. Owner of well: WOOD CUSTOM HOMES			
Street address of well location if in city: 5812 FRANKLIN WICHITA, KANS		R.R. or street: 906 N ARAPAHO			
4. Locate with "X" in section below:		City, state, zip code: WICHITA KANS 67212			
		Sketch map: BORED 8" HOLE TO 6.5 FT. INSTALLED 4" CASING - DROVE PIPE & POINT T COMPLETION - CRUTED CASING			
5. Type and color of material		6. Bore hole dia. 8 in. Completion date 10-31-77			
		Well depth 25 ft. FROM BASEMENT			
		7. Cable tool Rotary Driven Dug Hollow rod Jetted Bored Reverse rotary			
		8. Use: Domestic Public supply Industry Irrigation Air conditioning Stock Lawn Oil field water Other			
		9. Casing: Material RMP Height Above or below Threaded SOL Welded X Surface 12' BASEMENT RMP X PVC Weight 1.55 lbs./ft. Dia. 4 in. to 25 ft. depth Wall Thickness: inches or Dia. in. to ft. depth gage No. 200			
		10. Screen: Manufacturer's name CLAYTON Type BRASS Dia. 1.25 Slot/gauze .060 Length 4 FT. Set between 21 ft. and 25 ft. Gravel pack? NO Size range of material			
		11. Static water level: 6.5 ft. below land surface Date 10-31-77			
		12. Pumping level below land surfaces: ft. after hrs. pumping 1/4 g.p.m. ft. after hrs. pumping g.p.m. Estimated maximum yield 35 g.p.m.			
		13. Water sample submitted: mo./day/yr.			
		14. Well head completion: Pitless adapter 12' BASEMENT inches above grade			
		15. Well grouted? YES With: X Neat cement Bentonite Concrete Depth: From 0 ft. to 6.5 ft.			
		16. Nearest source of possible contamination: 12' Direction EAST Type PLASTIC SEWER Well disinfected upon completion? X Yes No			
		17. Pump: Not installed Manufacturer's name FFW Model number 50 HP 50 Volts 230 Length of drop pipe 25 ft. capacity 12 g.p.m. Type: Submersible Turbine X Jet Reciprocating Centrifugal Other			
18. Elevation: 1300 FT		19. Remarks:			
Topography: Hill Slope Upland Valley		20. Water well contractor's certification: This well was drilled under my jurisdiction and this report is true to the best of my knowledge and belief. BEARDEN PUMP & WELL 104 Business name License No. Address 3122 MENTOR WICHITA, KANS Signed O. W. Bearden Date 11/15/77 Authorized representative			

Forward the white, blue and pink copies to the Department of Health and Environment

Form WWC-5