USE TYPEWRITER OR BALL POINT PEN-PRESS FIRMLY, PRINT CLEARLY.

WATER WELL RECORD
KSA 82a-1201-1215

Kansas Department of Health and Environment-Division of Environment
(Water well Contractors)
Topeka, Kansas 66620

1. Location of well:	County	Fraction	Section number	Township number	Range number
	SEDGWICK	NE/4 NE/4 SE/4	15	T 27 S	R 1W E/W

2. Distance and direction from nearest town or city:
Street address of well location if in city: 5906 FRANKLIN WICHITA KANS.

3. Owner of well: WOOD CUSTOM HOMES
R.R. or street: 906 N ARAPAHO
City, state, zip code: WICHITA KANS 67212

4. Locate with "X" in section below:

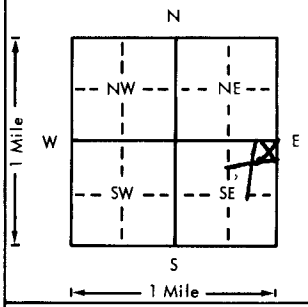

Sketch map: BORED 8" HOLE TO 6.5 FT. INSTALLED 4" CASING - DROVE PIPE + POINT TO COMPLETION GROUTED CASING

6. Bore hole dia. 8 in. Completion date 8-7-78
Well depth 25 ft. BASEMENT

7. __ Cable tool __ Rotary X Driven __ Dug
__ Hollow rod __ Jetted X Bored __ Reverse rotary

8. Use: X Domestic __ Public supply __ Industry
__ Irrigation __ Air conditioning __ Stock
__ Lawn __ Oil field water __ Other

9. Casing: Material RMP Height: Above or below
Threaded SOL Welded X Surface 12 in.
RMP X PVC __ Weight 1.55 lbs./ft.
Dia. 4 in. to 7.5 ft. depth Wall Thickness: inches or
Dia. __ in. to __ ft. depth gage No. 0.200

5. Type and color of material	From	To
SAND COARSE TAN	0	3
SAND COARSE RED	3	6.5
SAND COARSE RED H2O	6.5	
DROVE PIPE + POINT TO		
COMPLETION AT		25

(Use a second sheet if needed)

10. Screen: Manufacturer's name CLAYTON MARK
Type BRASS Dia. 1.25 IN.
Slot/gauze 0.60 Length 4 FT.
Set between 21 ft. and 25 ft.
__ ft. and __ ft.
Gravel pack? NO Size range of material __

11. Static water level: mo./day/yr.
6.5 ft. below land surface Date 8-7-78

12. Pumping level below land surfaces:
__ ft. after __ hrs. pumping NA g.p.m.
__ ft. after __ hrs. pumping __ g.p.m.
Estimated maximum yield 35 g.p.m.

13. Water sample submitted: mo./day/yr.
__ Yes X No Date __

14. Well head completion: BASEMENT
__ Pitless adapter 12 inches above grade

15. Well grouted? YES
With: X Neat cement __ Bentonite __ Concrete
Depth: From 0 ft. to 6.5 ft.

16. Nearest source of possible contamination:
ft. 12 Direction WEST Type SEWER
Well disinfected upon completion? X Yes __ No

17. Pump: Not installed
Manufacturer's name FW
Model number CPJ65S HP .50 Volts 230
Length of drop pipe 25 ft. capacity 12 g.p.m.
Type:
__ Submersible __ Turbine
X Jet __ Reciprocating
__ Centrifugal __ Other

18. Elevation: 1300'
Topography:
__ Hill
__ Slope
__ Upland
X Valley

19. Remarks:

20. Water well contractor's certification:
This well was drilled under my jurisdiction and this report is true to the best of my knowledge and belief.
BEARDEN PUMP & WELL
Business name License No. 104
Address 3142 MENTOR WICHITA KS
Signed [signature] Date 8/29/78
Authorized representative

27 T 1 R W 15 Sec NE NE SE

Forward the white, blue and pink copies to the Department of Health and Environment

Form WWC-5

MI-1023