USE TYPEWRITER OR BALL POINT PEN-PRESS FIRMLY, PRINT CLEARLY.

WATER WELL RECORD
KSA 82a-1201-1215

Kansas Department of Health and Environment-Division of Environment
(Water well Contractors)
Topeka, Kansas 66620

1. Location of well:	County	Fraction	Section number	Township number	Range number
	SEDGWICK	NW/4 NW/4 NW/4	15	T 27 S	R 1 E (W)

2. Distance and direction from nearest town or city:
Street address of well location if in city: 1227 MULBERRY PLACE WICHITA KANS

3. Owner of well: EW FAGYAL
R.R. or street: 1227 MULBERRY PLACE
City, state, zip code: WICHITA KANS, 67212

4. Locate with "X" in section below:

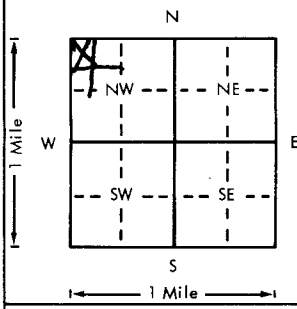

Sketch map: BORED 9" HOLE TO 10 FT. THEN 6" TO 16 FT. - USED SAN BUCKET TO COMPLETE AT 27.5 FT.

6. Bore hole dia. 9 in. Completion date 4-26-79
Well depth 27.5 ft FROM BASEMENT

7. __ Cable tool __ Rotary __ Driven __ Dug
__ Hollow rod __ Jetted X Bored __ Reverse rotary

8. Use: X Domestic __ Public supply __ Industry
__ Irrigation __ Air conditioning __ Stock
__ Lawn __ Oil field water __ Other

9. Casing: Material RMP Height: Above or below
Threaded __ Welded X Surface 0 in.
RMP X PVC __ Weight 1.55 lbs./ft.
Dia. 5 in. to 28.5 ft. depth Wall Thickness: inches or
Dia. __ in. to __ ft. depth gage No. 0.200

5. Type and color of material	From	To
CLAY - SANDY RED	0	6
CLAY - GRAY -	6	7
CLAY SANDY RED	7	14
SAND COARSE REDDISH	14	16
SAND COARSE TAN	16	27.5
CLAY YELLOW		
BOTTOMED CASING	27.5	

(Use a second sheet if needed)

10. Screen: Manufacturer's name SUNFLOWER
Type RMP Dia. 5 INCH
Slot/gauze .031 Length 7 FT.
Set between 20.5 ft. and 27.5 ft.
ft. and ft.
Gravel pack? NO Size range of material

11. Static water level 2 FT. BASEMENT - 23 FROM LAND mo./day/yr.
16 ft. below land surface Date 4-26-79

12. Pumping level below land surfaces:
ft. after hrs. pumping NA g.p.m.
ft. after hrs. pumping g.p.m.
Estimated maximum yield 65 g.p.m.

13. Water sample submitted: mo./day/yr.
__ Yes X No Date

14. Well head completion:
__ Pitless adapter 12 Inches above grade

15. Well grouted? YES
With: __ Neat cement __ Bentonite X Concrete
Depth: From 0 ft. to 10 ft.

16. Nearest source of possible contamination: SEWER
ft. 12 Direction WEST Type CAST IRON
Well disinfected upon completion? X Yes __ No

17. Pump: Not installed
Manufacturer's name FEW
Model number 10BK9 HP 1 Volts 230
Length of drop pipe 20 ft. capacity 9 g.p.m.
Type:
X Submersible __ Turbine
__ Jet __ Reciprocating
__ Centrifugal __ Other

T 27 S R 1 E (W) Sec 15

18. Elevation: 1300
Topography:
__ Hill
__ Slope
__ Upland
X Valley

19. Remarks:

20. Water well contractor's certification:
This well was drilled under my jurisdiction and this report is true to the best of my knowledge and belief.
Business name BEARDEN PUMP & WELL License No. 704
Address 3147 MENTOR WICHITA
Signed Otis W Bearden Date 5/23/79
Authorized representative

Forward the white, blue and pink copies to the Department of Health and Environment

Form WWC-5

M1-1023