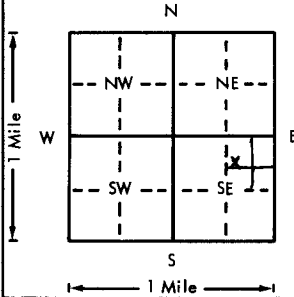
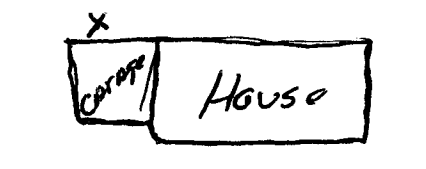


USE TYPEWRITER OR BALL
POINT PEN-PRESS FIRMLY,
PRINT CLEARLY.

WATER WELL RECORD
KSA 82a-1201-1215

Kansas Department of Health and
Environment-Division of Environment
(Water well Contractors)
Topeka, Kansas 66620

1. Location of well:		County Sedgwick	Fraction NW 1/4 NE 1/4 SE 1/4	Section number 15	Township number T 27 S R 1 E	Range number 1
2. Distance and direction from nearest town or city:		WICHITA, KS		3. Owner of well: Don Manning		
Street address of well location if in city:		5807 W. 8th		R.R. or street: 5807 W. 8th		
City, state, zip code:		WICHITA, KS				
4. Locate with "X" in section below:		Sketch map:		6. Bore hole dia. 11 in. Completion date 4-12-78 Well depth 30 ft.		
				7. ☐ Cable tool ☐ Rotary ☐ Driven ☐ Dug ☐ Hollow rod ☐ Jetted ☒ Bored ☐ Reverse rotary		
5. Type and color of material		From		To		8. Use: ☐ Domestic ☐ Public supply ☐ Industry ☒ Irrigation ☐ Air conditioning ☐ Stock ☒ Lawn ☐ Oil field water ☐ Other
TOP Soil		0		3		9. Casing: Material PVC Height: Above or below Threaded ☐ Welded ☐ Surface 12 in. RMP ☐ PVC ☒ Weight 2.75 lbs./ft. Dia. 5 in. to 30 ft. depth Wall Thickness: inches or Dia. ☐ in. to ☐ ft. depth gage No. 258
SAND		4		15		10. Screen: Manufacturer's name MODERN Type PVC Dia. 5.563 Slot/gauze .025 Length 5 Set between 25 ft. and 30 ft. ft. and ft. Gravel pack? NO Size range of material
Gravel		16		30		11. Static water level: 15 ft. below land surface Date 4-12-78 mo./day/yr.
						12. Pumping level below land surfaces: 15 ft. after 1 hrs. pumping 10 g.p.m. ft. after hrs. pumping g.p.m. Estimated maximum yield 500 g.p.m.
						13. Water sample submitted: NO mo./day/yr. Yes ☒ No ☐ Date
						14. Well head completion: 12 inches above grade Pitless adapter
						15. Well grouted? YES With: Bentonite Neat cement ☐ Concrete ☐ Depth: From 0 ft. to 10 ft.
						16. Nearest source of possible contamination: NO Direction N Type sewer Well disinfected upon completion? NO Yes ☐ No ☒
						17. Pump: X Not installed Manufacturer's name Model number HP Volts Length of drop pipe ft. capacity g.p.m. Type: ☐ Submersible ☐ Turbine ☐ Jet ☐ Reciprocating ☐ Centrifugal ☐ Other
18. Elevation:		19. Remarks:		20. Water well contractor's certification: This well was drilled under my jurisdiction and this report is true to the best of my knowledge and belief. 21st Electric Co. 129 Business name License No. Address 512 W. 21 Signed J. Harris Date 5-8-78 Authorized representative		

Forward the white, blue and pink copies to the Department of Health and Environment

Form WWC-5