USE TYPEWRITER OR BALL POINT PEN-PRESS FIRMLY, PRINT CLEARLY.

T R EW sec 1/4 1/4 1/4 No.

WATER WELL RECORD
KSA 82a-1201-1215

Kansas State Dept. Of Health
(Water Well Contractors)
Forbes-Bldg. 740
Topeka, Kansas 66620

1 Location of well:	County	Township name	Fraction	Section number	Town number	Range number
	Sedgwick	Wichita	SW-SE-SE	15	T-27-S	R1W

Distance and direction from nearest town or city:

Street address of well location if in city: SAME

3 Owner of well: L.D. Fallis

Address: 716 Boyd, Wichita, Ks.

Locate with "X" in section below:

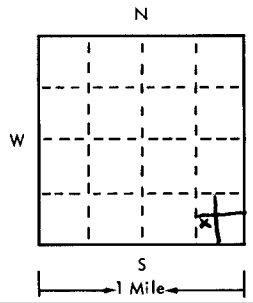

Sketch map:

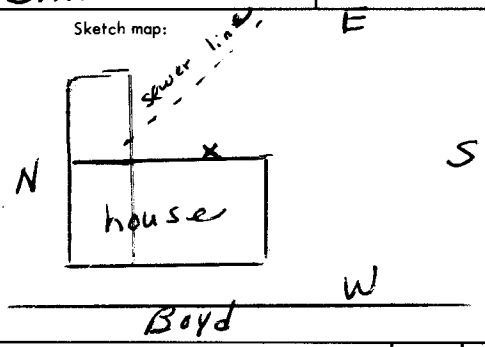

4 Well depth: 34 ft. Date of completion 4-15-76
Well diameter 10 in.

5 ☐ Cable tool ☐ Rotary ☐ Driven ☐ Dug
☐ Hollow rod ☐ Jetted ☒ Bored ☐ Reverse rotary

6 Use: ☒ Domestic ☐ Public supply ☐ Industry
☐ Irrigation ☐ Air conditioning ☐ Commercial
☐ Test well ☐ _____

7 Casing: Material RMP glued Height: above/below
Threaded ☐ Welded ☐ Surface 13 in.
Diam. Weight 200 lbs./ft.
6 in. to 24 ft. depth Drive shoe? ☐ Yes ☒ No
___ in. to ___ ft. depth

2 Type and color of material	From	To
black dirt	0	5
med. sand	5	20
Corse sand with gray clay balls	20	27
black clay	27	28
corse gravel	28	34
(use a second sheet if needed)		

8 Screen:
Manufacturer Sunflower
Type RMP Dia. 6 in
Slot/gauze 075 Length 2 in
Set between 24 ft. and 34 ft.
Fittings:
Gravel pack ☐ Yes ☒ No Size range of material ___

9 Static water level:
20 ft. below land surface Date 4-15-76

10 Pumping level below land surfaces:
___ ft. after ___ hrs. pumping ___ g.p.m.
___ ft. after ___ hrs. pumping ___ g.p.m.
Estimated maximum yield ___ g.p.m.

11 Water sample submitted:
☐ Yes ☒ No Date ___

12 Well head completion:
☒ Pitless adapter ☒ 13 Inches above grade

13 Well grouted? ☒ Yes ☐ No
☒ Neat cement ☐ Bentonite ☐ _____
Depth: From 0 ft. to 10 ft.

14 Nearest source of possible contamination:
ft. 25 Direction E Type sewer line
Well disinfected upon completion? ☒ Yes ☐ No

15 Pump: ☒ Not installed
Manufacturer's name _____
Model number _____ HP _____ Volts ___
Length of drop pipe ___ ft. capacity ___ g.m.p.
Type:
☐ Submersible ☐ Turbine
☐ Jet ☐ Reciprocating
☐ Certrifugal ☐ Other

16 Remarks: elevation

Topography:
☐ Hill
☒ Slope
☐ Upland
☐ Valley

17 Water well contractor's certification:
This well was drilled under my jurisdiction and this report is true to the best of my knowledge and belief.
Whitchurch Well Service 309
Business name License No.
Address 520 James Maize
Signed [signature] Date 5-1-76
Authorized representative

Forward the white, blue and pink copies to the Kansas State Dept. Of Health.

Form WWC-5

SW SE SE 15 T 27 S R 1 W

677-H