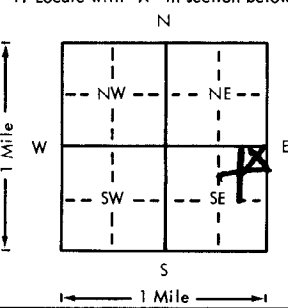


USE TYPEWRITER OR BALL
POINT PEN-PRESS FIRMLY,
PRINT CLEARLY.

WATER WELL RECORD
KSA 82a-1201-1215

Kansas Department of Health and
Environment-Division of Environment
(Water well Contractors)
Topeka, Kansas 66620

1. Location of well:		County	Fraction	Section number	Township number	Range number
		3 EDGWICK	NE NE SE	15	T 27 S	R 1W E
2. Distance and direction from nearest town or city:		3. Owner of well: WOOD CUSTOM HOMES				
Street address of well location if in city: 5914 FRANKLIN WICHITA KS		R.R. or street: 906 N. ARAPAHO WICHITA KANS, 67212				
4. Locate with "X" in section below:		Sketch map:				6. Bore hole dia. 8 in. Completion date 6/29/79
		BORED 8" HOLE TO 6.5 FT. INSTALLED 4" CASING, DROVE PIPE + POINT TO COMPLETION, GROUTED CASING				Well depth 25 ft. FROM BASEMENT
5. Type and color of material		From		To		7. Cable tool Rotary Driven Dug Hollow rod Jetted Bored Reverse rotary
SAND COARSE, TAN		0		6.5		8. Use: Domestic Public supply Industry Irrigation Air conditioning Stock Lawn Oil field water Other
SAND COARSE BROWNISH						9. Casing: Material RMP Height: Above or below Threading Welded X Surface 12 in. RMP PVC Weight 1.55 lbs./ft. Dia. 4 in. to 7.5 ft. depth Wall thickness inches or Dia. in. to ft. depth gage No. 0.200
H2O		6.5				10. Screen: Manufacturer's name SLAYTON MARK Brass RMP Dir. 1 1/4 INCH Slot/gauge 0.60 Length 4 FT. Set between 21 ft. and 25 ft. Gravel pack? NO Size range of material
DROVE PIPE + POINT TO COMPLETION AT				25		11. Static water level: 6.5 ft. below land surface Date 6/29/79
						12. Pumping level below land surfaces: ft. after hrs. pumping NA g.p.m. ft. after hrs. pumping g.p.m. Estimated maximum yield 35 g.p.m.
						13. Water sample submitted: Yes X No Date
						14. Well head completion: Pitless adapter 12 Inches above grade
						15. Well grouted? YES With: X Neat cement Bentonite Concrete Depth: From 0 ft. to 6.5 ft.
						16. Nearest source of possible contamination: 12 ft. Direction WEST PLASTIC SEWER Well disinfected upon completion? X Yes No
						17. Pump: Not installed Manufacturer's name FFW Model number C055 HP 0.50 Volts 230 Length of drop pipe 25 ft. capacity 12 g.p.m. Type: X Submersible Turbine Jet Reciprocating Centrifugal Other
18. Elevation: 1300 FT.		19. Remarks:		20. Water well contractor's certification: This well was drilled under my jurisdiction and this report is true to the best of my knowledge and belief. BEARDEN PUMPWELL Business name 2142 MENTOR License No. 062 W.B. 7/25/79 Signed Date		

Forward the white, blue and pink copies to the Department of Health and Environment

Form WWC-5