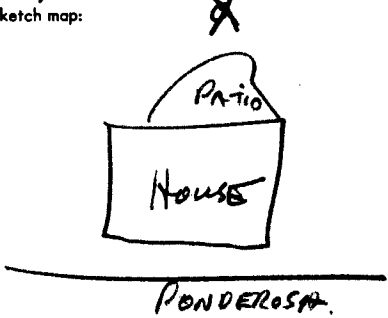


USE TYPEWRITER OR BALL
POINT PEN-PRESS FIRMLY,
PRINT CLEARLY.

WATER WELL RECORD
KSA 82a-1201-1215

Kansas Department of Health and
Environment-Division of Environment
(Water well Contractors)
Topeka, Kansas 66620

1. Location of well:		County SEOGEWICK	Fraction SW 1/4 NW 1/4 NE 1/4	Section number 16	Township number T 27 S	Range number R 1W E/W
2. Distance and direction from nearest town or city: Street address of well location if in city: 7825 PONDEROSA WICHITA, KS				3. Owner of well: Tom DANDRADE R.R. or street: 7825 PONDEROSA City, state, zip code: WICHITA, KANSAS		
4. Locate with "X" in section below: N W E S 1 Mile 1 Mile		Sketch map: 		6. Bore hole dia. 8 in. Completion date 6-1-77 Well depth 65 ft.		
				7. ☒ Cable tool ☒ Rotary ☐ Driven ☐ Dug ☐ Hollow rod ☐ Jetted ☐ Bored ☐ Reverse rotary		
				8. Use: ☐ Domestic ☐ Public supply ☐ Industry ☐ Irrigation ☐ Air conditioning ☐ Stock ☒ Lawn ☐ Oil field water ☐ Other		
				9. Casing: Material STEEL Height: Above or below Threaded ☐ Welded ☒ Surface 12 in. RMP ☐ PVC ☐ Weight 65 lbs./ft. Dia. 5 in. to 65 ft. depth Wall Thickness: inches or Dia. ☐ in. to ☐ ft. depth Gage No. 200 MK		
5. Type and color of material		From	To	10. Screen: Manufacturer's name YEL Type 200 Dia. 5" Slot/gauze .065 Length 10' Set between 55 ft. and 65 ft. Gravel pack? YES Size range of material ☐		
TOPSOIL		0	15	11. Static water level: 30 ft. below land surface Date 5-25-77		
SAND - FINE		16	30	12. Pumping level below land surfaces: 30 ft. after 1 hrs. pumping 15 g.p.m. ft. after ☐ hrs. pumping ☐ g.p.m. Estimated maximum yield 40 g.p.m.		
GRAVEL - COARSE		31	65	13. Water sample submitted: ☐ Yes ☒ No Date ☐		
				14. Well head completion: ☐ Pitless adapter 12 inches above grade		
				15. Well grouted? YES With: ☐ Neat cement ☐ Bentonite ☒ Concrete Depth: From 0 ft. to 10 ft.		
				16. Nearest source of possible contamination: SEWER ft. 30 Direction E Type ☐ Well disinfected upon completion? ☒ Yes ☐ No		
				17. Pump: ☒ Not installed Manufacturer's name DEPSTER Model number PH 2552 HP 3/4 Volts 220 Length of drop pipe 60 ft. capacity 20 g.p.m. Type: ☒ Submersible ☐ Turbine ☐ Jet ☐ Reciprocating ☐ Centrifugal ☐ Other		
		(Use a second sheet if needed)				
18. Elevation: Topography: ☐ Hill ☐ Slope ☒ Upland ☐ Valley		19. Remarks:			20. Water well contractor's certification: This well was drilled under my jurisdiction and this report is true to the best of my knowledge and belief. 2157 ELECTRIC DR. 129 Business name 512 W. 2157 License No. ☐ Address J. H. H. H. Date 6-8-77 Signed J. H. H. H. Authorized representative	

Forward the white, blue and pink copies to the Department of Health and Environment

Form WWC-5