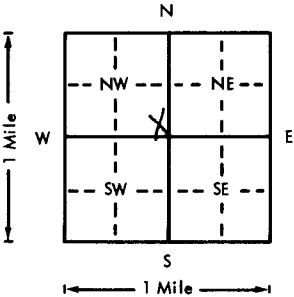
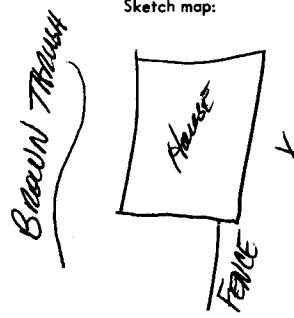


USE TYPEWRITER OR BALL
POINT PEN-PRESS FIRMLY,
PRINT CLEARLY.

WATER WELL RECORD
KSA 82a-1201-1215

Kansas Department of Health and
Environment-Division of Environment
(Water well Contractors)
Topeka, Kansas 66620

1. Location of well:		County SEDGEBWICK	Fraction SW NW NW SE SE 1/4 SE 1/4 NW 1/4	Section number 16	Township number T 27 S	Range number R 1 W	E/W
2. Distance and direction from nearest town or city: Street address of well location if in city: 954 BROWN THRUSS			3. Owner of well: ROBERT COREY R.R. or street: 954 BROWN THRUSS City, state, zip code: WICHITA, KS.				
4. Locate with "X" in section below: 			Sketch map: 		6. Bore hole dia. 8 in. Completion date 3-28-77 Well depth 60 ft.		
5. Type and color of material			From To		7. ☐ Cable tool ☒ Rotary ☐ Driven ☐ Dug ☐ Hollow rod ☐ Jetted ☐ Bored ☐ Reverse rotary		
					8. Use: ☐ Domestic ☐ Public supply ☐ Industry ☐ Irrigation ☐ Air conditioning ☐ Stock ☒ Lawn ☐ Oil field water ☐ Other		
					9. Casing: Material STY Height: ☒ Above or below Threaded ☐ Welded ☒ Surface 12 in. RMP ☐ PVC ☐ Weight 15 lbs./ft. Dia. 5 in. to 60 ft. depth Well Thickness: inches or Dia. ☐ in. to ☐ ft. depth gauge No. 200		
					10. Screen: Manufacturer's name JFL Type 200 Dia. 5" Slot/gauze .065 Length 10' Set between 50 ft. and 60 ft. ft. and ☐ ft. Gravel pack? ☒ Size range of material 4"		
Topsoil			0		10		
CLAY - GRAYISH			11		25		
SAND - FINE			26		50		
GRAVEL - COARSE			51		60		
					11. Static water level: ☐ mo./day/yr. 25 ft. below land surface Date 3-28-77		
					12. Pumping level below land surfaces: 25 ft. after 2 hrs. pumping 10 g.p.m. ft. after ☐ hrs. pumping ☐ g.p.m. Estimated maximum yield 25 g.p.m.		
					13. Water sample submitted: ☐ mo./day/yr. Yes ☒ No ☐ Date ☐		
					14. Well head completion: ☐ Pitless adapter 12 inches above grade		
					☒ Well grouted? YES With: ☐ Neat cement ☒ Bentonite ☐ Concrete Depth: From 0 ft. to 10 ft.		
					16. Nearest source of possible contamination: ft. 25 Direction E Type SEWER Well disinfected upon completion? ☐ Yes ☒ No		
					17. Pump: ☐ Npt installed Manufacturer's name Starlite Model number 8SP8661 HP 1/2 Volts 115 Length of drop pipe 55 ft. capacity 10 g.p.m. Type: ☒ Submersible ☐ Turbine ☐ Jet ☐ Reciprocating ☐ Centrifugal ☐ Other		
18. Elevation:					20. Water well contractor's certification: This well was drilled under my jurisdiction and this report is true to the best of my knowledge and belief. 2157 Electric 129 Business name 512 W. 21st License No. Address J. Hume Date 4-18-77 Signed J. Hume Authorized representative		
19. Remarks:							

Forward the white, blue and pink copies to the Department of Health and Environment

Form WWC-5