USE TYPEWRITER OR BALL POINT PEN-PRESS FIRMLY, PRINT CLEARLY.

WATER WELL RECORD
KSA 82a-1201-1215

Kansas Department of Health and Environment-Division of Environment
(Water well Contractors)
Topeka, Kansas 66620

1. Location of well:	County	Fraction	Section number	Township number	Range number
	Sedgwick	1/4 SE 1/4 SW 1/4	16	T 27 S	R 1W E/W

2. Distance and direction from nearest town or city:
Street address of well location if in city: 861 North Socora Wichita, Kansas

3. Owner of well: St. Francis Church
R.R. or street: 861 North Socora
City, state, zip code: Wichita, Kansas 67212

4. Locate with "X" in section below: Sketch map:

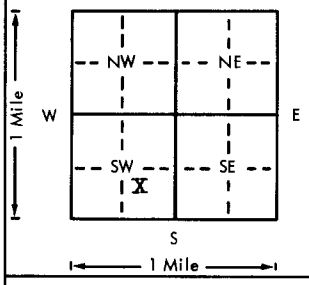

6. Bore hole dia. 11 in. Completion date 5-6-77
Well depth 80 ft.

7. __ Cable tool X Rotary __ Driven __ Dug
__ Hollow rod __ Jetted __ Bored __ Reverse rotary

8. Use: __ Domestic __ Public supply __ Industry
__ Irrigation __ Air conditioning __ Stock
X Lawn __ Oil field water __ Other

9. Casing: Material Styrene Height: Above or below
Threaded __ Welded gl Surface 12 in.
RMP X PVC __ Weight __ lbs./ft.
Dia. 5 in. to 80 ft. depth Wall Thickness: inches or
Dia. __ in. to __ ft. depth gage No. 200

5. Type and calar af material	From	To
Topsoil	0	3
Clay	3	20
Fine Sand	20	30
Medium Snad	30	38
Fine Sand	38	80

(Use a second sheet if needed)

10. Screen: Manufacturer's name Sunflower Plastic
Type Styrene Dia. 5"
Slot/gauze .06 Length 30
Set between 50 ft. ond 80 ft.
__ ft. and __ ft.
Gravel pack? yes Size range af material 1/4-1/8"

11. Stotic water level: mo./day/yr.
30 ft. below land surface Date 5-6-77

12. Pumping level below land surfaces:
__ ft. after __ hrs. pumping __ g.p.m.
__ ft. after __ hrs. pumping __ g.p.m.
Estimated maximum yield __ g.p.m.

13. Water sample submitted: mo./day/yr.
__ Yes __ No Date

14. Well head completion: Capped
__ Pitless adapter 12 Inches above grade

15. Well grouted? yes
With: __ Neat cement __ Bentonite X Concrete
Depth: From 40" ft. to 14 ft.

16. Nearest source of possible contaminatian: City
ft. 300 Direction North Type Sewer
Well disinfected upon completion? X Yes __ No

17. Pump: X Not installed
Manufacturer's name
Model number HP Volts
Length of drop pipe ft. capacity g.p.m.
Type:
__ Submersible __ Turbine
__ Jet __ Reciprocating
__ Centrifugal __ Other

18. Elevation:
Topography:
__ Hill
X Slope
__ Upland
__ Valley

19. Remarks: Well to be used for Sprinkler system only.

20. Water well contractor's certification:
This well was drilled under my jurisdiction and this report is true to the best of my knowledge and belief.
Harp Well & Pump 236
Business name License No.
Address Wichita, Kansas
Signed M. Arnold Date 5-26-77
Authorized representative

T 27 R 1W (E/W) Sec 16 1/4 1/4 1/4 SE SW

Forward the white, blue and pink copies to the Department of Health and Environment

Form WWC-5

MI-1023